

SUNFLOWER
P20
5-11-72

MISSISSIPPI
BOARD OF WATER COMMISSIONERS
416 North State Street
Jackson, Mississippi 39201

CODED

WATER WELL DRILLERS LOG

5-11 1972 DYER WELL & IRR. SUNFLOWER
date well completed firm name county well located

LANDOWNER:
BIRCHMOUNT PT. INC.
INDIANOLA MISS
(mailing address)

WELL LOCATION:
sec. 11 T 18 N R 5 W
3 miles S.W. of INDIANOLA
(distance) (direction) (nearest town)

description of formations encountered	from	to
CLAY	0	19
FINE SAND	19	34
CR. SAND	34	47
(CR. SAND & DEB)	47	113
ROCK		

WELL PURPOSE: IRR.
(home, irrigation, municipal, industrial)

- WELL COMPLETION DATA:
- (1) diameter (inches) 16"
 - (2) total depth (feet) 113'
 - (3) static water level (feet) 18' below top of ground.
 - (4) casing BUC IR 73'
(material) (depth)
16" (size) If telescope see back.
 - (5) screen 40 FT 73'
(length) (depth to top)
16" BUC IR.
(size) (material)
 - (6) pump 65 2,000
(HP) (yield gpm)
BUTANE
(type power)
 - (7) electric log No
(yes or no)
 - (organization running log)
 - (8) how well bottom plugged PLATE

CODED


MAY 19 1972

DRILLERS REMARKS:

MISS. DE. OF
WATER RESOURCES
RECORDS SECTION

If well telescopes please sketch and show depths.

GROUND LEVEL

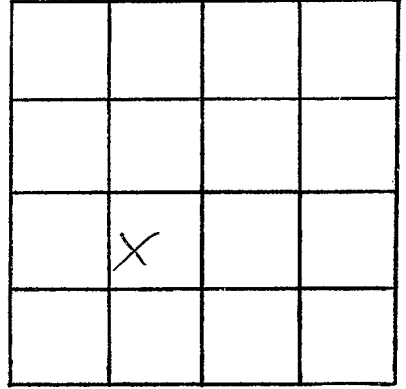

SECTION 11

Please indicate well location X.

ADDITIONAL INFORMATION

If more than one screen,
show locations of each on sketch.