

SUNFLOWER
P21
8-4-72
 8-4

MISSISSIPPI
 BOARD OF WATER COMMISSIONERS
 416 North State Street
 Jackson, Mississippi 39201

WATER WELL DRILLERS LOG

date well completed 8-4-72 firm name 72 Bailey Drilling Co county/well located Sunflower

LANDOWNER: Billy Barrett
Indianola
Miss
 (mailing address)

description of formations encountered	from	to
	0	40
Clay		
Sands	40	63
Gravel	63	68

WELL LOCATION:
 sec. 10 T. 18 N R. 5 E
 S W
4 miles W of Indianola
 (distance) (direction) (nearest town)

WELL PURPOSE: Home
 (home, irrigation, municipal, industrial)

- WELL COMPLETION DATA:
- (1) diameter (inches) 2"
 - (2) total depth (feet) 68 ft
 - (3) static water level (feet) 21 below above top of ground.
 - (4) casing Steel, 63'
 (material) (depth)
2 if telescope see back.
 (size)
 - (5) screen 5', 63'
 (length) (depth to top)
2", Stainless Steel
 (size) (material)
 - (6) pump 1/2, 5
 (HP) (yield gpm)
Elec
 (type power)
 - (7) electric log No
 (yes or no)

(organization running log)

(8) how well bottom plugged
Capped


DRILLERS REMARKS:

AUG 10 1972

STATE OF MISSISSIPPI
 BOARD OF WATER COMMISSIONERS

If well telescopes please sketch and show depths.

GROUND LEVEL

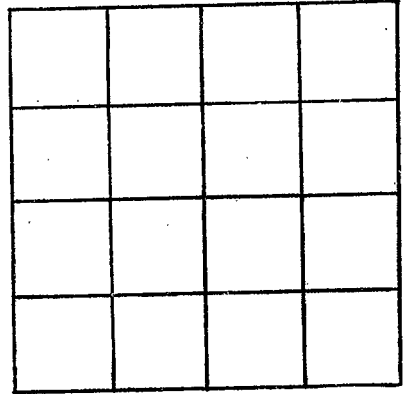

SECTION _____

Please indicate well location X.

ADDITIONAL INFORMATION

If more than one screen, show locations of each on sketch.