

Sunflower
P 22
4-67

MISSISSIPPI
BOARD OF WATER COMMISSIONERS
416 North State Street
Jackson, Mississippi 39201

WATER WELL DRILLERS LOG

4/29 1967 Dyer Well & Irrigation Sunflower
date well completed firm name county well located

LANDOWNER: Frank Tindall
R. R. Indianola.
Mississippi
(mailing address)


WELL LOCATION:
sec. 11 T. 18 N R. 5 E
S W
4 miles S. W. of Indianola
(distance) (direction) (nearest town)

description of formations encountered	from	to
	Clay	0
Med. Sand	23	63
Coarse Sand	63	83
Coarse sand & Gravel	83	113

WELL PURPOSE: Irrigation
(home, irrigation, municipal, industrial)

- WELL COMPLETION DATA:
- (1) diameter (inches) 10"
 - (2) total depth (feet) 113 Ft.
 - (3) static water level (feet) 21 below above top of ground.
 - (4) casing Bl. Iron Pipe, 81 Ft.,
(material) (depth)
 - if telescope see back.
(size)
 - (5) screen 32 Ft., 81 Ft.
(length) (depth to top)
10", Blk. Iron (Doerr)
(size) (material)
 - (6) pump 28 1,500
(HP) (yield gpm)
Tractor
(type power)
 - (7) electric log No
(yes or no)


(organization running log)
 - (8) how well bottom plugged Plate welded on bottom

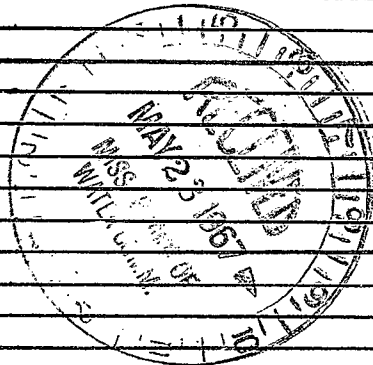

DRILLERS REMARKS:

If well telescopes please sketch and show depths.

GROUND LEVEL

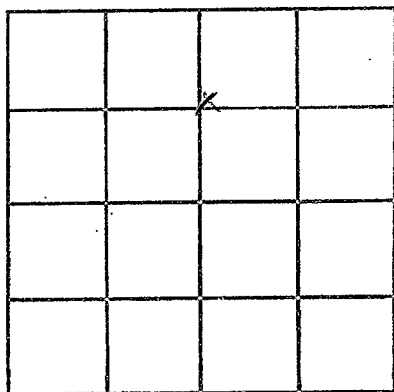

SECTION 14

Please indicate well location X.

ADDITIONAL INFORMATION

If more than one screen,
show locations of each on sketch.