

SUNF. MISSISSIPPI BOARD OF WATER COMMISSIONERS

P 24
2-18-64

WATER WELL DRILLERS LOG

Date: FEB 18, 1964, Driller: DELTA DRILLING Co. County SUNFLOWER
(Name)

(1) Owner of Land: WILLIE BETTS
(Name)
RTE 1, BOX 183 INDIANOLA, MISS
(Address)

(2) Location: NW 1/4, SW 1/4, Sec. 15 T18N R5W
_____ miles _____, of _____
(distance) (direction) (Nearest Town)

(3) Topography: _____
(Hilly) (Flat) (Level)

(4) Purpose of Well: DOMESTIC
(Domestic Irrigation
Municipal, Industrial, Other)

Description & Color of Materials Sand, Clay, Red Clay, Shell, etc.	Thick- ness Feet	Depth Feet
GUMBO	24	24
SAND	51	75
GRAVEL	33	108
SAND	32	140
GUMBO	165	305
SAND	52	357
SHALE	62	419
SAND	178	597
SHALE w/3" ROCK	104	701
GUMBO	134	835
SHALE w/6 & 8" ROCKS-	70	905
SAND w/3" ROCK	30	935
SHALE	63	968
GUMBO	51	1019
SAND	20	1039
SHALE	27	1066
GUMBO w/ROCKS	238	1304
GREEN SAND	80	1384
SHALE	10	1394
GREEN SAND	90	1484
SHALE	90	1574
GUMBO w/ROCKS.	80	1654
GREEN SAND	40	1694
GUMBO	57	1751
SAND- FINE SILTY	63	1814
WHITE SAND	115	1929
GUMBO	5	1934

Information upon completion of well:

(1) Diameter 3 inches.

(2) Total Depth 1934 feet.

(3) Water Level FLOWS feet below top of ground.

(4) Cased to 1914, Size 1190'-3", 766'-2"

(5) Screen: Size 2", Length 20'


(6) Were any formations sealed against pollution?

_____ yes, _____ no.

If YES depth of formation _____

Why _____

Drillers Remarks: 42' LAP OF 2" IN
3" PIPE

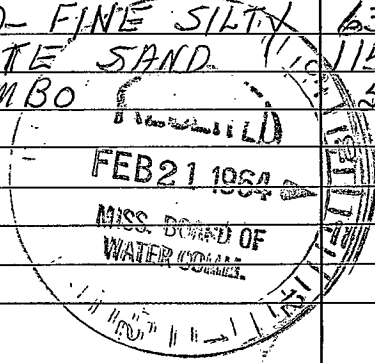

(Use Back Side)

Well No.

