

# SUNF. MISSISSIPPI BOARD OF WATER COMMISSIONERS

P 25  
3-17-64

## WATER WELL DRILLERS LOG

Date: MARCH 17, 1964, Driller: DELTA DRILLING Co County SUNFLOWER  
(Name)

(1) Owner of Land: HARLON SWANGO  
(Name)  
INDIANOLA, MISS.  
(Address)

(2) Location: SW 1/4, SW 1/4, Sec. 20 T8N R5W  
\_\_\_\_\_ miles \_\_\_\_\_, of \_\_\_\_\_  
(distance) (direction) (Nearest Town)

(3) Topography: \_\_\_\_\_  
(Hilly) (Flat) (Level)

(4) Purpose of Well: DOMESTIC  
(Domestic Irrigation  
Municipal, Industrial, Other)

Description & Color of Materials Sand, Clay, Red Clay, Shell, etc.	Thick- ness Feet	Depth Feet
GUMBO	22	22
SAND	64	86
GRAVEL	74	160
GUMBO	145	305
SHALE	31	336
SAND	72	408
GUMBO	92	500
SAND	115	615
GUMBO	150	765
SAND	42	807
SHALE	28	835
SAND	40	875
GUMBO	28	903
SAND	39	942
GUMBO	138	1080
SHALE	51	1131
GUMBO	83	1214
SHALE	24	1238
GUMBO W/3" ROCK	106	1344
SHALE W/ROCKS -	30	1374
SAND W/ROCKS -	140	1514
SHALE W/ROCKS	120	1634
SAND W/ROCKS -	80	1714
SHALE	84	1798
GUMBO	58	1856
SAND	141	1997
SHALE	16	2003

Information upon completion of well:

(1) Diameter 3 inches.

(2) Total Depth 2003 feet.

(3) Water Level FLOWS feet below top of ground.  
1200' - 3"

(4) Cased to 1983, Size 808' - 2"


(5) Screen: Size 2", Length 20'

(6) Were any formations sealed against pollution?  
\_\_\_\_\_ yes, \_\_\_\_\_ no.

If YES depth of formation \_\_\_\_\_

Why \_\_\_\_\_

Drillers Remarks: 25' LAP OF 2" IN 3"  
PIPE - WITH 10' - 2" TAIL  
PIPE ON BOTTOM END OF  
WELL

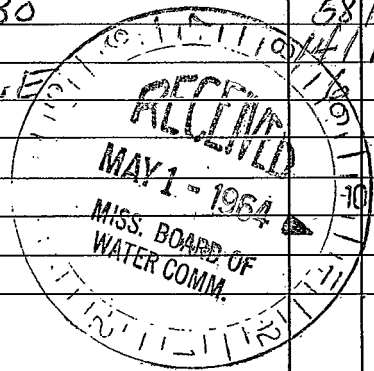

(Use Back Side)

Well No.

