

Sunflower
P 27

MISSISSIPPI BOARD OF WATER COMMISSIONERS

WATER WELL DRILLERS LOG

Sunflower

5-66

Date: May 10, 1966, Driller: Burtani Lee Co of Greenwood County Lepton
(Name)

(1) Owner of Land: Billups Plantation
(Name)

Indianola, Miss.
(Address)

(2) Location: SE 1/4, NW 1/4, Sec. 4 T18R15
5 miles West of Indianola
(distance) (direction) (Nearest Town)

(3) Topography: Flat
(Hilly) (Flat) (Level)

(4) Purpose of Well: Irrigation
(Domestic Irrigation
Municipal, Industrial, Other)

Description & Color of Materials Sand, Clay, Red Clay, Shell, etc.	Thick- ness Feet	Depth Feet
<u>Top soil</u>	<u>13</u>	<u>13</u>
<u>Brown Clay</u>	<u>10</u>	<u>23</u>
<u>Blue Clay</u>	<u>10</u>	<u>33</u>
<u>" "</u>	<u>10</u>	<u>43</u>
<u>Blue Clay Fine Sand</u>	<u>10</u>	<u>53</u>
<u>Med. Sand</u>	<u>10</u>	<u>63</u>
<u>Med. Sand</u>	<u>10</u>	<u>83</u>
<u>Coarse Sand & gravel</u>	<u>10</u>	<u>93</u>
<u>" " - Small gravel</u>	<u>10</u>	<u>103</u>
<u>" " - " "</u>	<u>10</u>	<u>113</u>
<u>" " - " "</u>	<u>10</u>	<u>123</u>

Information upon completion of well:

(1) Diameter 16 inches.

(2) Total Depth 115 feet.

(3) Water Level 20 feet below top of ground.

(4) Cased to 75, Size 16

(5) Screen: Size 16, Length 40


(6) Were any formations sealed against pollution?

no

If YES depth of formation _____

Why _____

Drillers Remarks: _____

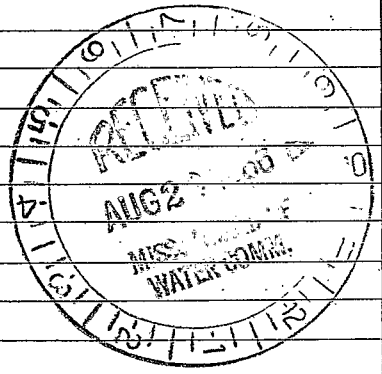

(Use Back Side)

Well No.

