

SUNFLOWER  
P 28  
7-3-19

MISSISSIPPI  
BOARD OF WATER COMMISSIONERS CODED  
416 North State Street  
Jackson, Mississippi 39201

WATER WELL DRILLERS LOG

7-3 1979 Larry Wolff Pump Co. Sunflower Co.  
date well completed firm name county well located

LANDOWNER: Weldon Koehn  
Indianola Miss

description of formations encountered	from	to
clay	6	7
fine sand	7	25
med sand	25	45
coarse sand	45	95
coarser sand & shell gravel	95	120

(mailing address)

WELL LOCATION:

sec. 6 T 18 N R 5 E  
S W  
6 miles West of Indianola  
(distance) (direction) (nearest town)

WELL PURPOSE:

(home, irrigation, municipal, industrial)

CODED

WELL COMPLETION DATA:

- diameter (inches) 10"
- total depth (feet) 120'
- static water level (feet) 18 below  
top of ground. ~~above~~
- casing plastic, 160'  
(material) (depth)  
  
(size) If telescope see back.
- screen 20', 100'  
(length) (depth to top)  
  
(size) plastic  
(material)
- pump 20 1000  
(HP) (yield gpm)  
  
gas  
(type power)
- electric log \_\_\_\_\_  
(yes or no)

(organization running log)

- how well bottom plugged plastic cap

DRILLERS REMARKS:


Miss. Board of Water Comm.

AUG 21 1979

RECEIVED

If well telescopes please sketch and show depths.

GROUND LEVEL

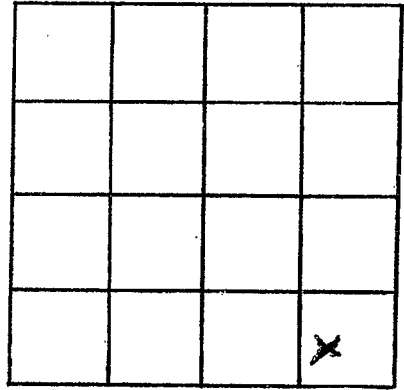

SECTION 6

Please indicate well location X.

ADDITIONAL INFORMATION

If more than one screen,  
show locations of each on sketch.