

SUNFLOWER
P29
2-14-79

MISSISSIPPI
BOARD OF WATER COMMISSIONERS
416 North State Street
Jackson, Mississippi 39201

CODED


WATER WELL DRILLERS LOG

February 14, 1979 Dyer Well & Irrigation Sunflower
date well completed firm name county well located

LANDOWNER: Fletcher Bros.	description of formations encountered	from	to
Indianola, Mississippi (mailing address)	CLAY FINE SAND SAND & GRAVEL	0 32 59	31 58 113
WELL LOCATION: sec. 11 T. 16 ^N R. 5 ^E S W 3 1/2 miles SW of Indianola (distance) (direction) (nearest town)	Bottom		113
WELL PURPOSE: irrigation (home, irrigation, municipal, industrial)	CODED		
WELL COMPLETION DATA: (1) diameter (inches) 12" (2) total depth (feet) 113' (3) static water level (feet) 16' below above top of ground. (4) casing Steel 73' (material) (depth) 12" if telescope see back. (size) (5) screen 40' 73' (length) (depth to top) 12" Steel (size) (material) (6) pump 40 1800-2000 (HP) (yield gpm) DIESEL (type power) (7) electric log No (yes or no) (organization running log) (8) how well bottom plugged Plate	Real 9-24-79 Dm		
DRILLERS REMARKS:			

If well telescopes please sketch and show depths.

GROUND LEVEL

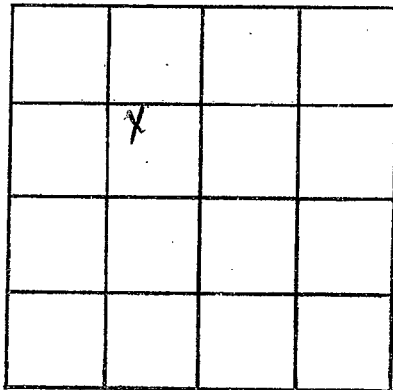

SECTION 11

Please indicate well location X.

ADDITIONAL INFORMATION

Lined area for additional information.

If more than one screen, show locations of each on sketch.