

MISSISSIPPI DEPARTMENT OF NATURAL RESOURCES

Bureau of Land and Water Resources

Southport Mall

P.O. Box 10631

Jackson, Mississippi 39209

WATER WELL DRILLERS LOG

CODED

| |
|-----------|
| SUNFLOWER |
| P 32 |
| 7-30-80 |

07/30/80 19 Larry's Well & Pump Sunflower
 date well completed firm name county well located

| LANDOWNER: <u>George Rice</u> | description of formations encountered | from | to |
|--|---------------------------------------|-------------|--------------|
| <u>Indianola, MS.</u> (mailing address) | <u>clay</u> | <u>0</u> | <u>2.5</u> |
| | <u>pink sand</u> | <u>2.5</u> | <u>2.10</u> |
| | <u>med & coarse sand</u> | <u>1.10</u> | <u>1.60</u> |
| WELL LOCATION: sec. <u>5</u> T. <u>18</u> N. R. <u>3</u> E. S. <u>1</u> W. <u>6</u> miles <u>West</u> of <u>Indianola</u> (distance) (direction) (nearest town) | | | |
| WELL PURPOSE: (home, irrigation, municipal, industrial) | | | CODED |
| WELL COMPLETION DATA: (1) diameter (inches) <u>10"</u> (2) total depth (feet) <u>100'</u> (3) static water level (feet) <u>17</u> below above top of ground. (4) casing <u>steel</u> , <u>60</u> , (material) (depth) (size) if telescope see back. (5) screen <u>2/0</u> , <u>60</u> (length) (depth to top) (size) (material) (6) pump <u>2/0</u> <u>1000</u> (HP) (yield gpm) <u>gas</u> (type power) (7) electric log <u>No</u> (yes or no) (organization running log) (8) how well bottom plugged <u>Steel Plate</u> | | | |
| DRILLERS REMARKS: | | | |


DEPT. OF NATURAL RESOURCES
 BUREAU OF LAND & WATER RESOURCES

APR 28 1981

RECEIVED

If well telescopes please sketch and show depths.

GROUND LEVEL

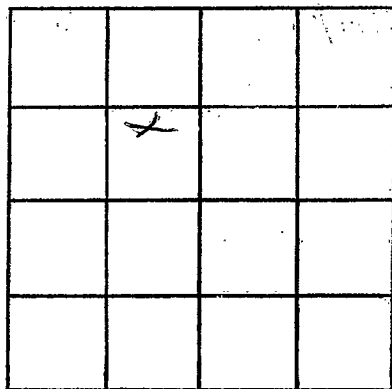

SECTION 5

Please indicate well location X.

ADDITIONAL INFORMATION

If more than one screen,
show locations of each on sketch.