

MISSISSIPPI DEPARTMENT OF NATURAL RESOURCES

Bureau of Land and Water Resources

Southport Mall

P.O. Box 10631

Jackson, Mississippi 39209

WATER WELL DRILLERS LOG

CODED

Sunflower  
P 33  
6-30-80

6/30/80 19 Larry's Well & Pump Sunflower  
 date well completed firm name county well located

LANDOWNER: George Rice

description of formations encountered

from

to

Indianola ms.  
 (mailing address)

slay 0 18  
med sand 18 30  
med & coarse sand 30 60  
coarse sand to gravel 60 114

WELL LOCATION:

sec. 9 T. 18 N. R. 5 E  
S W  
6 miles West of Indianola  
 (distance) (direction) (nearest town)

WELL PURPOSE:

(home, irrigation, municipal, industrial)

CODED

WELL COMPLETION DATA:

- (1) diameter (inches) 12"
- (2) total depth (feet) 114'
- (3) static water level (feet) 18 below above top of ground.
- (4) casing steel 74'  
 (material) (depth)
- (size) If telescope see back.
- (5) screen 240' 74'  
 (length) (depth to top)
- 12" steel  
 (size) (material)
- (6) pump 40 2000  
 (HP) (yield gpm)
- R  
 (type power)
- (7) electric log \_\_\_\_\_  
 (yes or no)

\_\_\_\_\_  
 (organization running log)

(8) how well bottom plugged S. plate

DRILLERS REMARKS:


DEPT. OF NATURAL RESOURCES  
 BUREAU OF LAND & WATER RESOURCES

APR 28 1981

RECEIVED

If well telescopes please sketch and show depths.

GROUND LEVEL

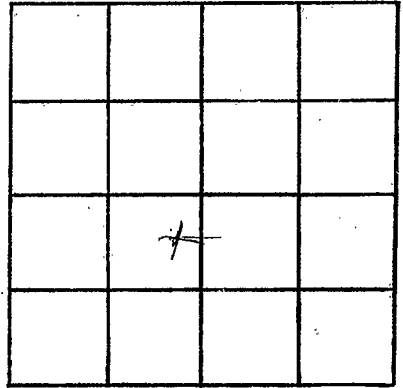

SECTION 7

Please indicate well location X.

ADDITIONAL INFORMATION

If more than one screen,  
show locations of each on sketch.