

MISSISSIPPI DEPARTMENT OF NATURAL RESOURCES

Bureau of Land and Water Resources

Southport Mall

P.O. Box 10631

Jackson, Mississippi 39209

WATER WELL DRILLERS LOG

CODED

SUNFLOWER
P 34
8-16-80

08/16 1980 date well completed Larry's Well & Pump firm name sunflower county well located

LANDOWNER: Shine Mitchell

description of formations encountered

from

to

Indianola, MS. (milling address)

clay	0	50
Fine sand	20	30
med sand	30	60
coarse sand & gravel	60	114'


WELL LOCATION:

sec. 4 T. 18 N R. 5 W
 5 miles W of Indianola (distance) (direction) (nearest town)

WELL PURPOSE: Private (home, irrigation, municipal, industrial)

WELL COMPLETION DATA:


- (1) diameter (inches) 10"
- (2) total depth (feet) 114'
- (3) static water level (feet) 17' below top of ground.
- (4) casing steel (material), 74' (depth)
- (size) If telescope see back.
- (5) screen 40 (length), 74' (depth to top)
- (size) (material)
- (6) pump 10 (HP), 7500 (yield gpm)
- Electric (type power)
- (7) electric log NO (yes or no)
- (organization running log)
- (8) how well bottom plugged

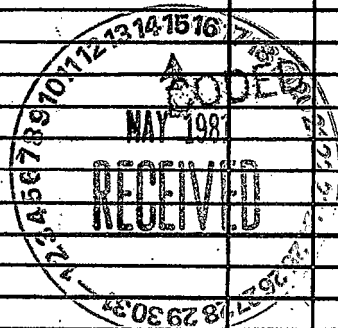

DRILLERS REMARKS:

If well telescopes please sketch and show depths.

GROUND LEVEL

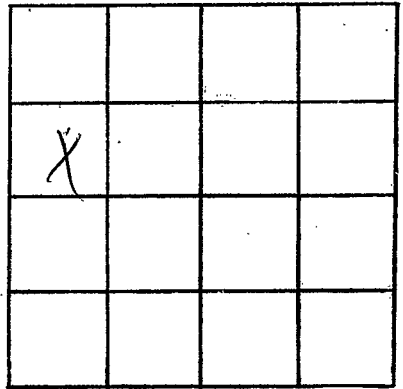

SECTION 4

Please indicate well location X.

ADDITIONAL INFORMATION

If more than one screen,
show locations of each on sketch.