

MISSISSIPPI DEPARTMENT OF NATURAL RESOURCES

Bureau of Land and Water Resources

Southport Mall

P.O. Box 10631

Jackson, Mississippi 39209

0051

WATER WELL DRILLERS LOG CODED

Sunflower
P36
2-11-81
GW 4279
2/11 1981

Dyer

Sum

date well completed

firm name

county well located

LANDOWNER:

J. B. SYKES

description of formations encountered

from to

Nolly Ridge, MS.
 (mailing address)

Clay	0	28
fine sand	28	38
sand	38	49
sand & gravel	49	103

WELL LOCATION:

sec. 9 T. 18 (N) R. 5 E
4 miles SW of Prentiss
 (distance) (direction) (nearest town)


WELL PURPOSE:

(home, irrigation, municipal, industrial)

CODED

WELL COMPLETION DATA:


- (1) diameter (inches) 12"
- (2) total depth (feet) 103'
- (3) static water level (feet) 20' below above top of ground.
- (4) casing stal 103'
 (material) (depth)
12" If telescope see back.
 (size)
- (5) screen 40' 63'
 (length) (depth to top)
12" stal
 (size) (material)
- (6) pump 40 2000
 (HP) (yield gpm)
diesel
 (type power)
- (7) electric log _____
 (yes or no)

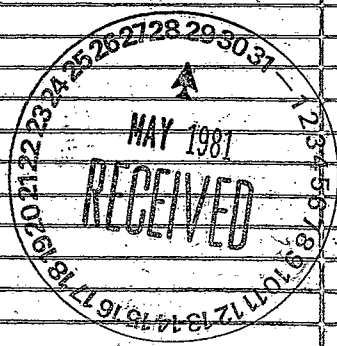

(organization running log)

(8) how well bottom plugged plate

DRILLERS REMARKS:

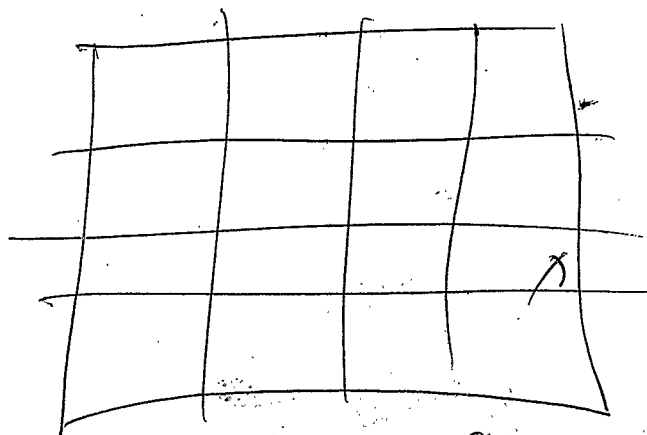

See 9