

Sunflower  
P 37  
4-4-80

MISSISSIPPI  
BOARD OF WATER COMMISSIONERS  
416 North State Street  
Jackson, Mississippi 39201

CODED

WATER WELL DRILLERS LOG

4/4 19 80  
date well completed

firm name

Sun  
county well located

LANDOWNER:

FLETCHER BROS

INDIANOLA, MS  
(mailing address)

description of formations encountered

from

to

Clay	0	28
fine sand	28	38
sand	38	48
hard + gravel	48	103

WELL LOCATION:

sec. 10 T 18 N R 5 E  
3 miles SW of Indianola  
(distance) (direction) (nearest town)


WELL PURPOSE:

(home, irrigation, municipal, industrial)

WELL COMPLETION DATA:

- (1) diameter (inches) 12"
- (2) total depth (feet) 103'
- (3) static water level (feet) 20' below top of ground.
- (4) casing Steel 103'  
(material) (depth)  
12" if telescope see back.  
(size)
- (5) screen 40' 63'  
(length) (depth to top)  
12" Steel  
(size) (material)
- (6) pump 40 2000  
(HP) (yield gpm)  
Diesel  
(type power)
- (7) electric log (yes or no)
- (organization running log)
- (8) how well bottom plugged plate


CODED

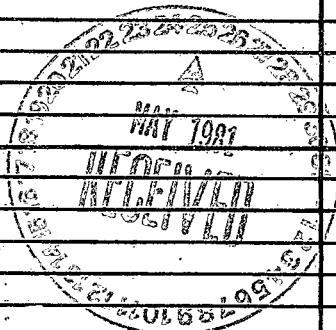

DRILLERS REMARKS:

If well telescopes please sketch and show depths.

GROUND LEVEL

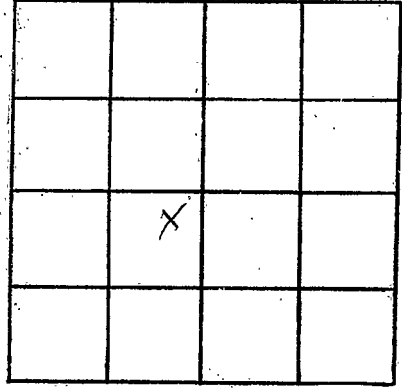

SECTION 10

Please indicate well location X.

ADDITIONAL INFORMATION

If more than one screen,  
show locations of each on sketch.