

MISSISSIPPI DEPARTMENT OF NATURAL RESOURCES

Bureau of Land and Water Resources

CODED

Southport Mall

P.O. Box 10631

Jackson, Mississippi 39209

WATER WELL DRILLERS LOG

CODED

Sunflower
P 38
6-20-81
6/20/81

date well completed

firm name

county well located

19 Sunflower Well & 200 Sunflower

LANDOWNER:

description of formations encountered

from

to

Billipps
Indiana, Ms

(mailing address)

<u>Clay</u>	<u>0</u>	<u>20</u>
<u>Fine sand</u>	<u>28</u>	<u>70</u>
<u>Sand</u>	<u>78</u>	<u>85</u>
<u>Sand + gravel</u>	<u>85</u>	<u>118</u>

WELL LOCATION:

sec. 4 T. 18 N. R. 5 E.
S. W.
4 miles W of INDIANA
(distance) (direction) (nearest town)

WELL PURPOSE:

(home, irrigation, municipal, industrial)

WELL COMPLETION DATA:


- (1) diameter (inches) 16
- (2) total depth (feet) 118
- (3) static water level (feet) 22 below above top of ground.
- (4) casing 16 (material), 118 (depth),
If telescope see back.
(size)
- (5) screen 40 (length), (depth to top)
16 (size), (material)
- (6) pump 60 (HP), 3000 (yield gpm)
DISC (type power)
- (7) electric log NO (yes or no)

(organization running log)

(8) how well bottom plugged quite


DRILLERS REMARKS:

CODED

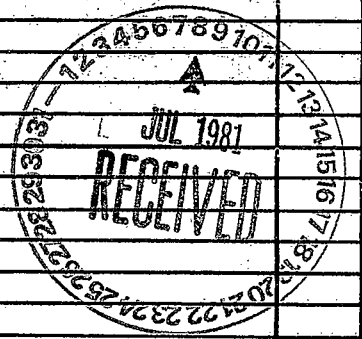

If well telescopes please sketch and show depths.

GROUND LEVEL

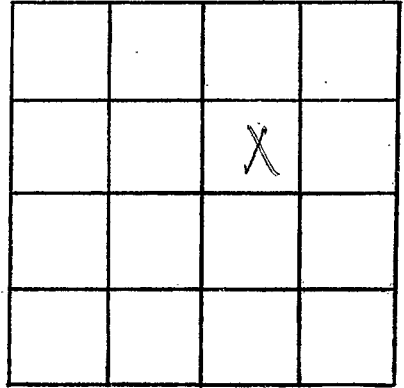

SECTION _____

Please indicate well location X.

ADDITIONAL INFORMATION

If more than one screen,
show locations of each on sketch.