

Sunflower  
P39  
10/7/81

MISSISSIPPI DEPARTMENT OF NATURAL RESOURCES  
Bureau of Land and Water Resources  
Southport Mall  
P.O. Box 10631  
Jackson, Mississippi 39209  
WATER WELL DRILLERS LOG

CODED

10-7 1981 Dyer Well + Irrigation Sunflower  
date well completed firm name county well located

LANDOWNER: Holly Ridge Pkg. Co.

description of formations encountered	from	to
---------------------------------------	------	----

(mailing address)

Clay	0	25
------	---	----

WELL LOCATION:  
sec. 6 T. 18 N. R. 5 E. S. W.  
6 miles W of Indianola  
(distance) (direction) (nearest town)

find sand	25	55
sand + gravel	55	103

WELL PURPOSE:  
(home, irrigation, municipal, industrial)

WELL COMPLETION DATA:

CODED

- (1) diameter (inches) 16"
- (2) total depth (feet) 103'
- (3) static water level (feet) 21' below top of ground.
- (4) casing Steel, 63' (material) (depth)  
16" (size) if telescope see back.
- (5) screen 40" (length), 63' (depth to top)  
16" (size), Mild Steel (material)
- (6) pump 40 (HP), 2000 (yield gpm)  
electric (type power)
- (7) electric log No (yes or no)  
None (organization running log)
- (8) how well bottom plugged Plate


DEPT. OF NATURAL RESOURCES  
BUREAU OF LAND & WATER RESOURCES  
OCT 15 1981

DRILLERS REMARKS:

RECEIVED

If well telescopes please sketch and show depths.

GROUND LEVEL

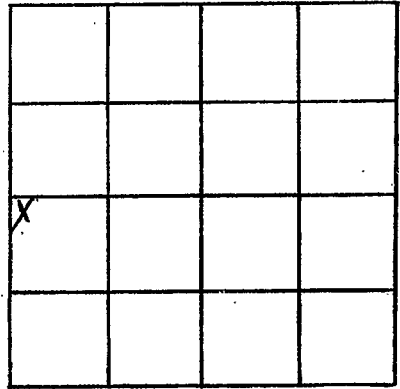

SECTION 6

Please indicate well location X.

ADDITIONAL INFORMATION

If more than one screen,  
show locations of each on sketch.