

**SUNFLOWER**  
 P42  
 6-25-81

MISSISSIPPI DEPARTMENT OF NATURAL RESOURCES  
 Bureau of Land and Water Resources  
 Southport Mall  
 P.O. Box 10631  
 Jackson, Mississippi 39209  
**WATER WELL DRILLERS LOG**

**CODED**

June 25 19 81 date well completed  
 Bruce Berryman firm name  
 SUNFLOWER county well located  
 Greenwood.

**LANDOWNER:** Charles Barrett  
 8 Lewis Circle  
 Indianola. MS 38751  
 (mailing address)

**WELL LOCATION:**  
 sec. 4 T. 18 N R. 5 W  
 5 miles of Indianola  
 (distance) (direction) (nearest town)

**WELL PURPOSE:** Home  
 (home, irrigation, municipal, industrial)

**WELL COMPLETION DATA:**

- (1) diameter (inches) 4" x 2"
- (2) total depth (feet) 567'
- (3) static water level (feet) 20' below  
 top of ground. Blk - 84'
- (4) casing 2" galv - 463'  
 (material) (depth)  
 (size) if telescope see back.
- (5) screen 20' 547'  
 (length) (depth to top)  
 2" .010, Stainless steel  
 (size) (material)
- (6) pump 2 45  
 (HP) (yield gpm)  
 Electric  
 (type power)
- (7) electric log NO  
 (yes or no)  
 (organization running log)
- (8) how well bottom plugged B.P.V.

description of fomations encountered	from	to
Clay	0	40
Sand	40	100
Sand & Gravel	100	160
Clay & Str. sand	160	260
Sand	260	340
Shale	340	380
Fine sand	380	400
Shale	400	470
Fine sand	470	560
Shale	560	580
Sand	580	600
Shale	600	650

**CODED**

DEPT. OF NATURAL RESOURCES  
 BUREAU OF LAND & WATER RESOURCES


NOV 19 1981

**RECEIVED**

**DRILLERS REMARKS:**

If well telescopes please sketch and show depths.

GROUND LEVEL

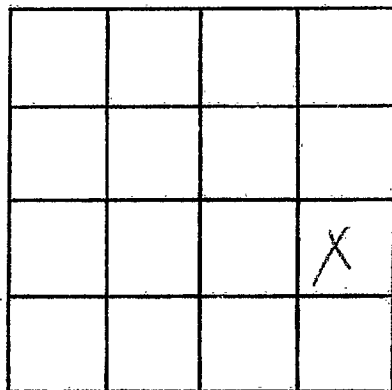

SECTION 4

Please indicate well location X.

ADDITIONAL INFORMATION

If more than one screen,  
show locations of each on sketch.