

MISSISSIPPI DEPARTMENT OF NATURAL RESOURCES

Bureau of Land and Water Resources

Southport Mall

P.O. Box 10631

Jackson, Mississippi 39209

WATER WELL DRILLERS LOG

CODED

Amphora
PU3
12/10/81

12-10 date well completed 1981 Dyer Well + Irrigation firm name Sunflower county well located

LANDOWNER: Fletcher Bros.	description of formations encountered	from	to
Indianola (mailing address)	CLAY	0	13
	Finesand + Clay	13	23
WELL LOCATION: sec. 9 T. 8 N. R. 5 E. S. 1 W. 1 2 miles SW of Orland (distance) (direction) (nearest town)	Course Sand	23	33
	" "	33	43
WELL PURPOSE: Irrigation (home, irrigation, municipal, industrial)	" "	43	53
	" "	53	63
WELL COMPLETION DATA: (1) diameter (inches) 12 3/4" (2) total depth (feet) 103 (3) static water level (feet) 17 below top of ground. (4) casing Steel, 63 (material), (depth) 12 3/4" (size) if telescope see back. (5) screen 40' (length), (depth to top) 12 3/4", Mild Steel (size), (material) (6) pump 40 (HP), 2500 (yield gpm) diesel (type power) (7) electric log No (yes or no) (organization running log) (8) how well bottom plugged Plate	SAND + GRAVEL	63	73
	SAND + GRAVEL	73	83
	" "	83	93
	" "	93	103
DRILLERS REMARKS:			


DEPT. OF NATURAL RESOURCES
 BUREAU OF LAND & WATER RESOURCES

JUN 30 1982

RECEIVED

If well telescopes please sketch and show depths.

GROUND LEVEL

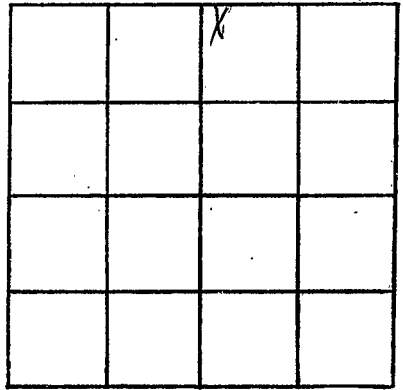

SECTION 9

Please indicate well location X.

ADDITIONAL INFORMATION

If more than one screen,
show locations of each on sketch.