

MISSISSIPPI DEPARTMENT OF NATURAL RESOURCES
Bureau of Land and Water Resources
 Southport Mall
 P.O. Box 10631 **CODED**
 Jackson, Mississippi 39209
WATER WELL DRILLERS LOG

Sunflower
P 44
215/82

2-15 1982 Oyster Well Sunflower
 date well completed firm name county well located

LANDOWNER: AK Maxwell
AK Maxwell
 (mailing address)

WELL LOCATION:
 sec. 25 T. 18 (N) R. 5 E
5 miles NW of Inverness
 (distance) (direction) (nearest town)

WELL PURPOSE: Irrigation
 (home, irrigation, municipal, industrial)

WELL COMPLETION DATA:

(1) diameter (inches) 16
 (2) total depth (feet) 103
 (3) static water level (feet) 18 below above top of ground.
 (4) casing Steel, 63,
 (material) (depth)
16 if telescope see back.
 (size)
 (5) screen 40', 63
 (length) (depth to top)
16", mild steel
 (size) (material)
 (6) pump 300 2400
 (HP) (yield gpm)
Diesel
 (type power)
 (7) electric log No
 (yes or no)
 (organization running log)
 (8) how well bottom plugged Plate

description of formations encountered	from	to
CLAY	0	13
CLAY	13	23
CLAY	23	33
CLAY + Sand	33	43
Fine Sand	43	53
C Sand	53	63
C Sand	63	73
C Sand	73	83
Sand Gravel	83	93
Sand Gravel	93	103
	103	

DRILLERS REMARKS:


DEPT. OF NATURAL RESOURCES
 BUREAU OF LAND & WATER RESOURCES

JUN 30 1982

RECEIVED

If well telescopes please sketch and show depths.

GROUND LEVEL

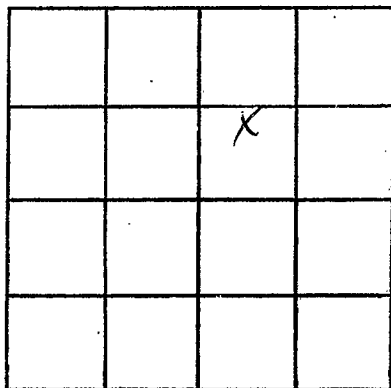

SECTION 25

Please indicate well location X.

ADDITIONAL INFORMATION

If more than one screen,
show locations of each on sketch.