

MISSISSIPPI DEPARTMENT OF NATURAL RESOURCES  
 Bureau of Land and Water Resources  
 Southport Mall  
 P.O. Box 10631  
 Jackson, Mississippi 39209  
**WATER WELL DRILLERS LOG**

**CODED**

*Sumflowed*  
 P 45  
 03/4/82

3-4 19 *82* *Dyer Well* *Sumflowed*  
 date well completed firm name county well located

LANDOWNER: *Brunfield*  
 (mailing address)

| description of fomations encountered | from      | to         |
|--------------------------------------|-----------|------------|
| <i>Clay</i>                          | <i>0</i>  | <i>14</i>  |
| <i>Fine Sand</i>                     | <i>14</i> | <i>20</i>  |
| <i>Sand</i>                          | <i>28</i> | <i>80</i>  |
| <i>Sand &amp; gravel</i>             | <i>80</i> | <i>120</i> |

WELL LOCATION:  
 sec. ~~35~~ T *18* N S R *5* E W  
*7* miles *W* of *Sumner*  
 (distance) (direction) (nearest town)

WELL PURPOSE:  
 (home, irrigation, municipal, industrial)

- WELL COMPLETION DATA:
- (1) diameter (inches) *16*
  - (2) total depth (feet) *120*
  - (3) static water level (feet) *18* below above top of ground.
  - (4) casing *Steel*, *80*,  
 (material) (depth)  
*16* if telescope see back.  
 (size)
  - (5) screen *40*, *80*  
 (length) (depth to top)  
*16*, *Mild Steel*  
 (size) (material)
  - (6) pump *100* *1700*  
 (HP) (yield gpm)  
*diesel*  
 (type power)
  - (7) electric log *No*  
 (yes or no)  
 (organization running log)
  - (8) how well bottom plugged *Plate*


DRILLERS REMARKS:

DEPT. OF NATURAL RESOURCES  
 BUREAU OF LAND & WATER RESOURCES

JUN 30 1982  
**RECEIVED**

If well telescopes please sketch and show depths.

GROUND LEVEL

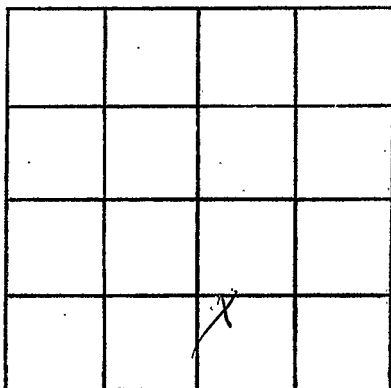

SECTION 35

Please indicate well location X.

ADDITIONAL INFORMATION

If more than one screen,  
show locations of each on sketch.