

MISSISSIPPI DEPARTMENT OF NATURAL RESOURCES
Bureau of Land and Water Resources
 Southport Mall
 P.O. Box 10631
 Jackson, Mississippi 39209
WATER WELL DRILLERS LOG

CODED

Sanflow
#46
1118182

Nov. 8 1981 Dyer Wells Irrigation Sanflow
 date well completed firm name county well located

LANDOWNER: <u>Holly Ridge Ph. Co.</u>	description of formations encountered	from	to
(mailing address)	Clay	0	18
WELL LOCATION: sec. <u>8</u> T. <u>R</u> N. <u>5</u> S. R. <u>5</u> E. <u>W</u>	Fine Sand	18	40
<u>2</u> miles <u>RS</u> of <u>Holly Ridge</u> (distance) (direction) (nearest town)	Clay	40	56
WELL PURPOSE: <u>Irrigation</u> (home, irrigation, municipal, industrial)	Sand & gravel	56	113
WELL COMPLETION DATA:			
(1) diameter (inches) <u>16"</u>			
(2) total depth (feet) <u>113</u>			
(3) static water level (feet) <u>18</u> below above top of ground.			
(4) casing <u>Steel</u> , <u>73</u> , (material) (depth) <u>16"</u> If telescope see back. (size)			
(5) screen <u>40'</u> , <u>73</u> (length) (depth to top) <u>16"</u> , <u>Mild Steel</u> (size) (material)			
(6) pump <u>40</u> , <u>2500</u> (HP) (yield gpm) <u>butane</u> (type power)			
(7) electric log <u>No</u> (yes or no)			
(organization running log)			
(8) how well bottom plugged <u>Plate</u>			
DRILLERS REMARKS:			


DEPT. OF NATURAL RESOURCES
 BUREAU OF LAND & WATER RESOURCES

SEP 30 1982

RECEIVED

If well telescopes please sketch and show depths.

GROUND LEVEL

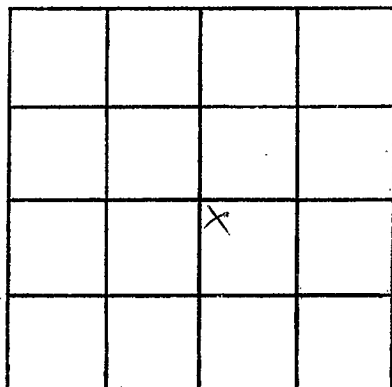

SECTION 8

Please indicate well location X.

ADDITIONAL INFORMATION

If more than one screen,
show locations of each on sketch.