

MISSISSIPPI DEPARTMENT OF NATURAL RESOURCES

Bureau of Land and Water Resources

Southport Mall

P.O. Box 10631

Jackson, Mississippi 39209

CODED

WATER WELL DRILLERS LOG

Sunflower  
MP47  
4/30/82

19 1982  
 date well completed

Dyer Well & Drilling  
 firm name

Sunflower  
 county well located

LANDOWNER: Holly Ridge

description of formations encountered	from	to
<u>C' Layer</u>	<u>0</u>	<u>11</u>
<u>Thin Sand</u>	<u>11</u>	<u>40</u>
<u>Sand + Gravel</u>	<u>40</u>	<u>54</u>
<u>Thin sand</u>	<u>54</u>	<u>80</u>
<u>Sand + Gravel</u>	<u>80</u>	<u>121</u>

(Interstate Chem)  
 (mailing address)

WELL LOCATION:  
 sec. 17 T. R. 8 (N) S. R. 5 E. (W)  
4 miles S of Holly Ridge  
 (distance) (direction) (nearest town)

WELL PURPOSE:  
 (home, irrigation, municipal, industrial)

WELL COMPLETION DATA:

- (1) diameter (inches) 16
- (2) total depth (feet) 121
- (3) static water level (feet) 22 below top of ground.
- (4) casing Steel, 81 (material) (depth)
- (size) if telescope see back.
- (5) screen 40', 40' (length) (depth to top)
- 16", steel (size) (material)
- (6) pump 200, 1800 (HP) (yield gpm)
- diesel (type power)
- (7) electric log no (yes or no)
- no (organization running log)
- (8) how well bottom plugged plate

DRILLERS REMARKS:


DEPT. OF NATURAL RESOURCES  
 BUREAU OF LAND & WATER RESOURCES

FEB - 3 1983

RECEIVED

If well telescopes please sketch and show depths.

GROUND LEVEL

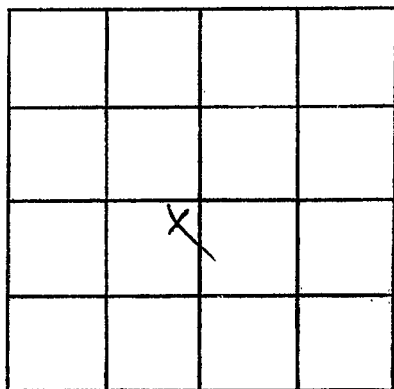

SECTION 17

Please indicate well location X.

ADDITIONAL INFORMATION

If more than one screen,  
show locations of each on sketch.