

MISSISSIPPI DEPARTMENT OF NATURAL RESOURCES

Bureau of Land and Water Resources

Southport Mall

P.O. Box 10631

Jackson, Mississippi 39209

WATER WELL DRILLERS LOG

CODED

P48  
4-19-83

April 19, 1983 date well completed  
Larry's well & pump firm name  
Jefferson county well located

LANDOWNER: Charles Robertson

description of formations encountered	from	to
clay	0	20
Sand	20	50
Sand & gravel	50	116

(mailing address)

WELL LOCATION:

sec. 7 T 18 N R 5 E  
S W  
2 miles South of Holly Ridge  
(distance) (direction) (nearest town)

WELL PURPOSE:

(home, irrigation, municipal, industrial)

CODED

WELL COMPLETION DATA:

- (1) diameter (inches) 16"
- (2) total depth (feet) 116'
- (3) static water level (feet) 21 <sup>below</sup> ~~above~~ top of ground.
- (4) casing Steel 76'  
(material) (depth)  
(size) If telescope see back.
- (5) screen 40' 76'  
(length) (depth to top)  
16" Steel  
(size) (material)
- (6) pump 100 1600  
(HP) (yield gpm)  
(type power)
- (7) electric log No  
(yes or no)  
(organization running log)
- (8) how well bottom plugged Steel Plate

DEPT. OF NATURAL RESOURCES  
BUREAU OF LAND & WATER RESOURCES


SEP 26 1983

RECEIVED

DRILLERS REMARKS:

If well telescopes please sketch and show depths.

GROUND LEVEL

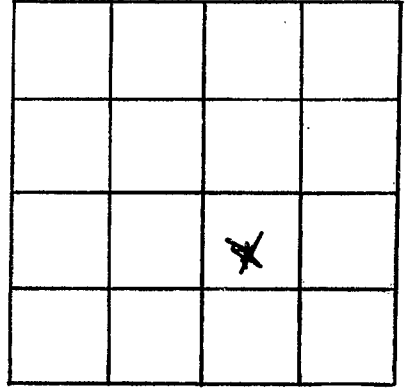

SECTION 7

Please indicate well location X.

ADDITIONAL INFORMATION

If more than one screen,  
show locations of each on sketch.