

MISSISSIPPI DEPARTMENT OF NATURAL RESOURCES

Bureau of Land and Water Resources

Southport Mall

P.O. Box 10631

Jackson, Mississippi 39209

CODED

WATER WELL DRILLERS LOG

BUTANE GAS COMPANY

OF GREENWOOD

firm name

Sunflower

county well located

P50
Sunflower
11-9-83
GW 6732

11-9 1983 date well completed

LANDOWNER: M.H. McGreary  
 (mailing address)

description of formations encountered	from	to
	CLAY	0
SAND	10	50
SAND + Red Gravel	50	105

WELL LOCATION:  
 sec. 21 T. 18 N. R. 5 E. S. W  
6 miles S.W. of Indianola  
 (distance) (direction) (nearest town)

WELL PURPOSE:  
 (home, irrigation, municipal, industrial)

WELL COMPLETION DATA:

(1) diameter (inches) 16"

(2) total depth (feet) 105'

(3) static water level (feet) 25 below above top of ground.

(4) casing Steel 65'  
 (material) (depth)

16 If telescope see back.  
 (size)

(5) screen 40, 65'  
 (length) (depth to top)

16, Steel  
 (size) (material)

(6) pump 60 1100  
 (HP) (yield gpm)

Direct  
 (type power)

(7) electric log No  
 (yes or no)

No  
 (organization running log)

(8) how well bottom plugged Steel plate

DRILLERS REMARKS:  
Carlos Ramos

DEPT. OF NATURAL RESOURCES  
BUREAU OF LAND & WATER RESOURCES


DEC 15 1983

RECEIVED

If well telescopes please sketch and show depths.

GROUND LEVEL

WATER TABLE  
OF GLENWOOD

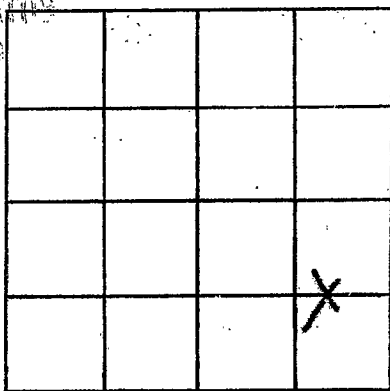

SECTION 21

Please indicate well location X.

ADDITIONAL INFORMATION

If more than one screen, show locations of each on sketch.