

P52
 Sunflower Co
 3-23-84

MISSISSIPPI DEPARTMENT OF NATURAL RESOURCES
 Bureau of Land and Water Resources
 Southport Mall
 P.O. Box 10631
 Jackson, Mississippi 39209
WATER WELL DRILLERS LOG

CODED

March 23, 1984 Irrigation Equipment, Inc. Sunflower
 date well completed firm name county well located
 P.O. Box 708 Indianola, Ms. 38751

LANDOWNER: A.K. Maxwell
 Route 1,
 Moorhead, Ms. 38761
 (mailing address)

description of formations encountered	from	to
Clay	0	20
Fine Sand	20	60
Fine Sand & Clay	60	65
Coarse Sand & Gravel	65	105

WELL LOCATION:
 sec. 25 T. 18 S. R. 5 E.
6 miles W of Invernes
 (distance) (direction) (nearest town)

WELL PURPOSE: Irrigation
 (home, irrigation, municipal, industrial)

WELL COMPLETION DATA:

- (1) diameter (inches) 16"
- (2) total depth (feet) 105'
- (3) static water level (feet) 15 below above top of ground.
- (4) casing Steel, 65'
 (material) (depth)
 _____ if telescope see back.
 (size)
- (5) screen 40", 65'
 (length) (depth to top)
12", Steel
 (size) (material)
- (6) pump 60 1200
 (HP) (yield gpm)
Deisel
 (type power)
- (7) electric log _____
 (yes or no)

 (organization running log)

(8) how well bottom plugged Steel Plate

DRILLERS REMARKS:

CODED


DEPT. OF NATURAL RESOURCES
 BUREAU OF LAND & WATER RESOURCES

APR - 6 1984

RECEIVED

If well telescopes please sketch and show depths.

GROUND LEVEL

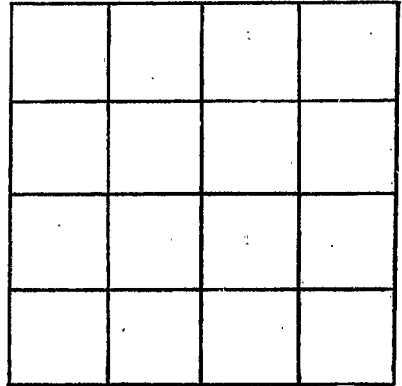

SECTION _____

Please indicate well location X.

ADDITIONAL INFORMATION

If more than one screen,
show locations of each on sketch.