

MISSISSIPPI DEPARTMENT OF NATURAL RESOURCES

Bureau of Land and Water Resources

Southport Mall

P.O. Box 10631

CODED

Jackson, Mississippi 39209

WATER WELL DRILLERS LOG

P53
Sunflower

Sunflower
Humphreys

1984 J + K Irrigation + Well

date well completed

firm name

county well located

LANDOWNER:
J. B. Reel
Inverness, Miss.
(mailing address)

description of formations encountered

from to

CLAY 0 12
FINE SAND 12 38
SAND GRAVEL 38 103

WELL LOCATION:

sec 22 T 18 N R 5 E
S W (W)
4 miles SW of Indianola
(distance) (direction) (nearest town)

WELL PURPOSE:

(home irrigation municipal, industrial)

WELL COMPLETION DATA:

- (1) diameter (inches) 12
- (2) total depth (feet) 103
- (3) static water level (feet) 18 below above top of ground.
- (4) casing steel, 63, (material) (depth)
12 if telescope see back. (size)
- (5) screen 40, 63 (length) (depth to top)
12, steel (size) (material)
- (6) pump 80, 1200 (HP) (yield gpm)
diesel (type power)
- (7) electric log no (yes or no)

(organization running log)

(8) how well bottom plugged plate

DRILLERS REMARKS:


DEPT. OF NATURAL RESOURCES
BUREAU OF LAND & WATER RESOURCES

MAY 31 1984

RECEIVED

If well telescopes please sketch and show depths.

GROUND LEVEL

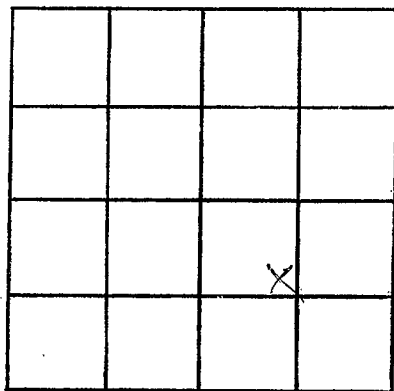

SECTION 22

Please indicate well location X.

ADDITIONAL INFORMATION

If more than one screen,
show locations of each on sketch.