

SUNFLOWER
P 55

MISSISSIPPI DEPARTMENT OF NATURAL RESOURCES
Bureau of Land and Water Resources
Southport Mall
P.O. Box 10631
Jackson, Mississippi 39209
WATER WELL DRILLERS LOG

CODED

7-8-84 19 Irrigation Equipment SUNFLOWER
date well completed firm name county well located

LANDOWNER: Charles Barnett
7 Spring Circle
Indianola, Mo. 37751
Flood (mailing address)

description of formations encountered	from	to
	Clay	0
Sand/clay	26	35
fine sand	36	65
Sand/gravel	66	115

WELL LOCATION:
sec. 20 T. 18 N. R. 5 E
S W
7 miles SW of Indianola
(distance) (direction) (nearest town)

WELL PURPOSE: Irrigation
(home, irrigation, municipal, industrial)

CODED

- WELL COMPLETION DATA:
- (1) diameter (inches) 16"
 - (2) total depth (feet) 115
 - (3) static water level (feet) 18 below above top of ground.
 - (4) casing Steel, 75'
(material) (depth)
(size) If telescope see back.
 - (5) screen 40' 75'
16" (length) (depth to top)
(size) (material) Steel
 - (6) pump 60 3000
(HP) (yield gpm)
Diesel power unit
(type power)
 - (7) electric log (yes or no)
 - (organization running log)
 - (8) how well bottom plugged steel plate


DRILLERS REMARKS:

DEPT. OF NATURAL RESOURCES
BUREAU OF LAND & WATER RESOURCES

SEP - 4 1984
RECEIVED

If well telescopes please sketch and show depths.

GROUND LEVEL

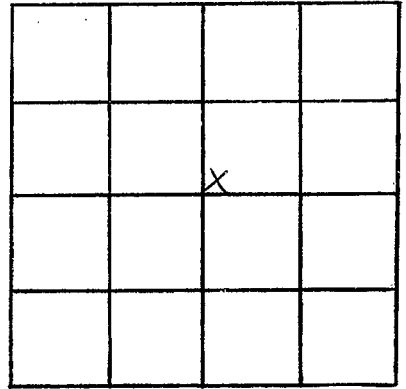

SECTION 20

Please indicate well location X.

ADDITIONAL INFORMATION

If more than one screen,
show locations of each on sketch.