

MISSISSIPPI DEPARTMENT OF NATURAL RESOURCES

Bureau of Land and Water Resources

Southport Mall

P.O. Box 10631

CODED

Jackson, Mississippi 39209

WATER WELL DRILLERS LOG

SUNFLOWER
P 56

4-2-84
date well completed

19 Irrigation Equipment
firm name

Sunflower
county well located

LANDOWNER: Jeff Anthony

description of formations encountered

from

to

310 Shaw Ave.

Indianola, Mo. 65751

Pivot (mailing address)

WELL LOCATION:

sec 28 T 18 N R 5 E
7 miles SW of INDIANOLA
(distance) (direction) (nearest town)

Clay 0 10
fine sand 11 55
coarse sand 56 75
coarse sand/gravel 76 115

WELL PURPOSE: Irrigation
(home, irrigation, municipal, industrial)

CODED

WELL COMPLETION DATA:

- (1) diameter (inches) 12"
- (2) total depth (feet) 115
- (3) static water level (feet) 18 below above top of ground.
- (4) casing steel, 75' (material) (depth)

if telescope see back.
(size)

- (5) screen 40' 75' (length) (depth to top)
12" steel (size) (material)

- (6) pump (HP) (yield gpm)
(type power)

- (7) electric log (yes or no)

(organization running log)

- (8) how well bottom plugged seal plate

DRILLERS REMARKS:


DEPT OF NATURAL RESOURCES
BUREAU OF LAND & WATER RESOURCES

SEP - 4 1984

RECEIVED

If well telescopes please sketch and show depths.

GROUND LEVEL

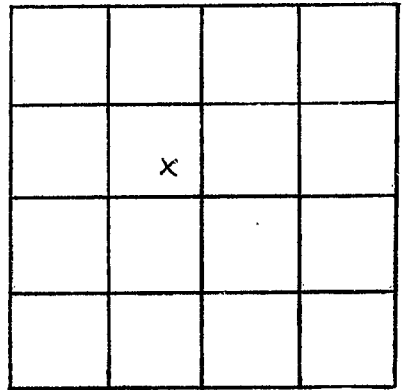

SECTION 28

Please indicate well location X.

ADDITIONAL INFORMATION

If more than one screen,
show locations of each on sketch.