

**MISSISSIPPI DEPARTMENT OF NATURAL RESOURCES**  
 Bureau of Land and Water Resources  
 Southport Mall  
 P.O. Box 10631  
 Jackson, Mississippi 39209  
**WATER WELL DRILLERS LOG**

**CODED**

SUNFLOWER  
P 57

7-5-84 19 IRRIGATION equipment Sunflower  
 date well completed firm name county well located

**LANDOWNER:** FRANK Tindall  
Route 1, Box 226  
Indianola, Mo. 63951  
 (mailing address)

description of formations encountered	from	to
CLAY	0	21
SAND	22	61
SAND + GRAVEL	62	105

**WELL LOCATION:**  
 sec. 15 T. 18 (N) R. 5 E  
5 miles SW of Indianola  
 (distance) (direction) (nearest town)

**WELL PURPOSE:** IRRIGATION  
 (home, irrigation, municipal, industrial)

- WELL COMPLETION DATA:**
- diameter (inches) 12"
  - total depth (feet) 105
  - static water level (feet) 20 below above top of ground.
  - casing steel 65'  
 (material) (depth)  
 (size) If telescope see back.
  - screen 40' 65'  
 (length) (depth to top)  
12" steel  
 (size) (material)
  - pump 30 1300  
 (HP) (yield gpm)  
Elec  
 (type power)
  - electric log (yes or no) \_\_\_\_\_  
 (organization running log) \_\_\_\_\_
  - how well bottom plugged steel Plate

**CODED**

DEPT. OF NATURAL RESOURCES  
 BUREAU OF LAND & WATER RESOURCES


SEP - 4 1984

**RECEIVED**

**DRILLERS REMARKS:** \_\_\_\_\_

If well telescopes please  
sketch and show depths.

GROUND LEVEL

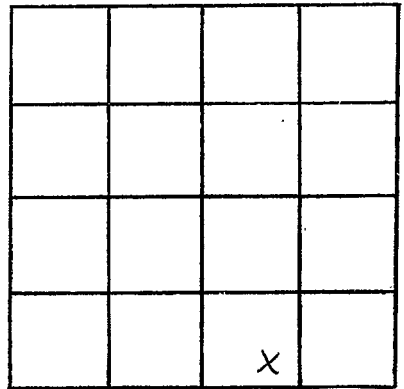

SECTION 15

Please indicate well location X.

ADDITIONAL INFORMATION

If more than one screen,  
show locations of each on sketch.