

MISSISSIPPI DEPARTMENT OF NATURAL RESOURCES

Bureau of Land and Water Resources

Southport Mall

P.O. Box 10631

Jackson, Mississippi 39209

WATER WELL DRILLERS LOG

CODED

SUNFLOWER
P 58

5-15 1994 Irrigation equipment Sunflower
date well completed firm name county well located

LANDOWNER: Holly Ridge
Planting Co; James Robertson
P.O. Box 95
Holly Ridge, Mo. 38749
(mailing address)

description of formations encountered	from	to
<u>Clay</u>	<u>0</u>	<u>15</u>
<u>fine sand</u>	<u>16</u>	<u>46</u>
<u>sand mixed coal</u>	<u>46</u>	<u>60</u>
<u>COARSE SAND + GRAVEL</u>	<u>61</u>	<u>115</u>

WELL LOCATION:
sec. 7 T. 18 N. R. 5 E
S W
2 miles South of Holly Ridge
(distance) (direction) (nearest town)

WELL PURPOSE: Irrigation
(home, irrigation, municipal, industrial)

WELL COMPLETION DATA:

- (1) diameter (inches) 16"
- (2) total depth (feet) 115
- (3) static water level (feet) 19 below above top of ground.
- (4) casing steel, 75'
(material) (depth)
(size) If telescope see back.
- (5) screen 40', 75'
(length) (depth to top)
16", steel
(size) (material)
- (6) pump 60
(HP) (yield gpm)
Diesel Power unit
(type power)
- (7) electric log (yes or no) _____
(organization running log) _____
- (8) how well bottom plugged Steel Plate

DRILLERS REMARKS:


DEPT. OF NATURAL RESOURCES
BUREAU OF LAND & WATER RESOURCES

SEP - 4 1994

RECEIVED

If well telescopes please sketch and show depths.

GROUND LEVEL

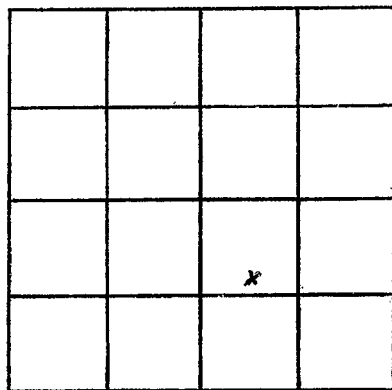

SECTION 7

Please indicate well location X.

ADDITIONAL INFORMATION

If more than one screen,
show locations of each on sketch.