

MISSISSIPPI DEPARTMENT OF NATURAL RESOURCES

Bureau of Land and Water Resources

Southport Mall

P.O. Box 10631

Jackson, Mississippi 39209

CODED

WATER WELL DRILLERS LOG

SUNFLOWER  
P 59

6-85 19  
 date well completed

Cook Drilling Co.  
 firm name

Sunflower  
 county well located

LANDOWNER:

Mrs. Vic. Zapponi  
Archievale Miss  
 (mailing address)

description of formations encountered

Clay Sand  
Field Sand  
Sand & gravel

from

to

top 12'  
15' 65'  
65' 120'

WELL LOCATION:

sec. 6 T 18 N R 5 E  
 S W  
5 miles west of Archievale  
 (distance) (direction) (nearest town)

CODED

WELL PURPOSE:

(home, irrigation, municipal, industrial)

WELL COMPLETION DATA:

- (1) diameter (inches) 12"
- (2) total depth (feet) 120
- (3) static water level (feet) 27 below above top of ground.
- (4) casing Steel, 120'  
 (material) (depth)  
12" if telescope see back.  
 (size)
- (5) screen 40, 80'  
 (length) (depth to top)  
12", Steel  
 (size) (material)
- (6) pump 40, 800  
 (HP) (yield gpm)  
Pump  
 (type power)
- (7) electric log \_\_\_\_\_  
 (yes or no)  
 \_\_\_\_\_  
 (organization running log)
- (8) how well bottom plugged \_\_\_\_\_


RECEIVED  
 SEP 29 1986

Department of Natural Resources  
 Bureau of Land & Water Resources

DRILLERS REMARKS:

If well telescopes please sketch and show depths.

GROUND LEVEL

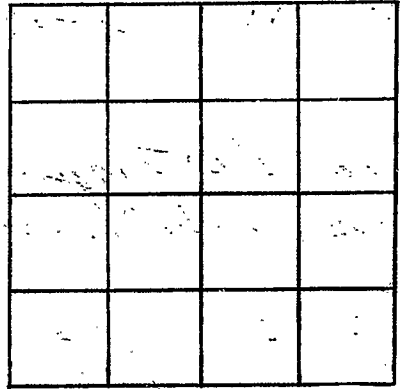

SECTION \_\_\_\_\_

Please indicate well location X-

ADDITIONAL INFORMATION

If more than one screen,  
show locations of each on sketch.