

MISSISSIPPI DEPARTMENT OF NATURAL RESOURCES

Bureau of Land and Water Resources

Southport Mall

P.O. Box 10631

CODED

Jackson, Mississippi 39209

WATER WELL DRILLERS LOG

SUNFLOWER
P 60

6-85 19 date well completed Cook Drilling Co. firm name Sunflower county well located

LANDOWNER: Mrs. V. [unclear]
[unclear] (mailing address)

description of formations encountered	from	to
Clay Sand	Top	12'
Gravel Sand	12'	66'
Sand + Gravel	66'	120'

WELL LOCATION: sec 5 T 18 N R 5 E S W
5 miles west of [unclear] (distance) (direction) (nearest town)

CODED

WELL PURPOSE: Cotton (home, irrigation, municipal, industrial)

- WELL COMPLETION DATA:
- (1) diameter (inches) 12"
 - (2) total depth (feet) 120
 - (3) static water level (feet) 28 below top of ground.
 - (4) casing steel, 80' (material) (depth)
12" (size) if telescope see back.
 - (5) screen 40' (length), 80' (depth to top)
12" (size), steel (material)
 - (6) pump 40 (HP), 800 (yield gpm)
Dural (type power)
 - (7) electric log (yes or no)
(organization running log)
 - (8) how well bottom plugged Plate




SEP 29 1966

Department of Natural Resources
Bureau of Land & Water Resources

DRILLERS REMARKS:

If well telescopes please
sketch and show depths.

GROUND LEVEL

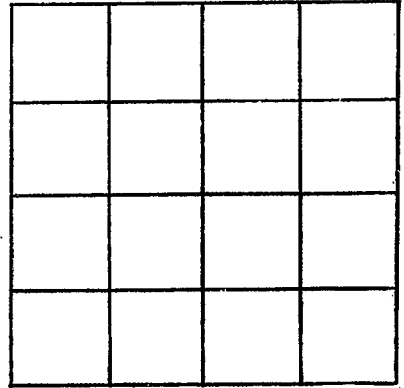

SECTION _____

Please indicate well location X.

ADDITIONAL INFORMATION

If more than one screen,
show locations of each on sketch.