

#1

MISSISSIPPI
 BOARD OF WATER COMMISSIONERS
 416 North State Street
 Jackson, Mississippi 39201

CODED

WATER WELL DRILLERS LOG

Sunflower
P 100
7-19-68

7-19 1968 Dyer Well Dr. SUNFLOWER
 date well completed firm name county well located

LANDOWNER: Bullard Pet Inc

description of formations encountered

from to

INDIANOLA,

CLAY

0 13

MISS,

CLAY

13 23

(mailing address)

CLAY

23 28

WELL LOCATION:

FINE SAND

28 33

sec. 2 T 18 N R 5 E
 S W
7 miles S.W. of INDIANOLA
 (distance) (direction) (nearest town)

COARSE SAND / PER GRA.

33 93

LARGE 93 103

WELL PURPOSE: DR.
(home, irrigation, municipal, industrial)

WELL COMPLETION DATA:

- (1) diameter (inches) 16"
- (2) total depth (feet) 103'
- (3) static water level (feet) 31' below above top of ground.
- (4) casing BULL. DR. 63'
(material) (depth)
16" if telescope see back.
(size)
- (5) screen 40' 63'
(length) (depth to top)
16" BULL. DR.
(size) (material)
- (6) pump 50 2000
(HP) (yield gpm)
BRAND
(type power)
- (7) electric log no
(yes or no)

(organization running log)
- (8) how well bottom plugged PLATE


CODED

DRILLERS REMARKS:

SEP 2 1968
 MISS. BUS. ON WATER

If well telescopes please sketch and show depths.

GROUND LEVEL

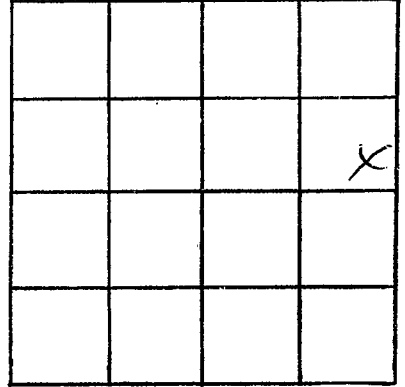

SECTION 2

Please indicate well location X.

ADDITIONAL INFORMATION

If more than one screen, show locations of each on sketch.