

#7

Sunflower  
P101  
7-29-68

MISSISSIPPI  
BOARD OF WATER COMMISSIONERS  
416 North State Street  
Jackson, Mississippi 39201

CODED

WATER WELL DRILLERS LOG

7-29 1968 Dyer Well Irr. SUNFLOWER  
date well completed firm name county well located

LANDOWNER: BILLARS PET INC.

description of formations encountered

from to

INDIANOLA,

CLAY

0 24

MISS

FINE SAND

24 63

(mailing address)

MED SAND

63 73

WELL LOCATION:

COARSE SAND

73 103

sec. 8 T. 18 N. R. 5 E  
1 1/2 miles SW. of HEATHMAN  
(distance) (direction) (nearest town)

WELL PURPOSE: IRR.  
(home, irrigation, municipal, industrial)

WELL COMPLETION DATA:

CODED

- (1) diameter (inches) 16"
- (2) total depth (feet) 103 FT
- (3) static water level (feet) 20' below above top of ground.
- (4) casing DEXTR 63'  
(material) (depth)  
16" if telescope see back.  
(size)
- (5) screen 40' 63'  
(length) (depth to top)  
16" BLK. IR.  
(size) (material)
- (6) pump 50 700  
(HP) (yield gpm)  
BUTANE  
(type power)
- (7) electric log NO  
(yes or no)

(organization running log)


(8) how well bottom plugged PLATE

DRILLERS REMARKS:

DEC 2  
1968  
MISS. Bd. OF  
WATER COMMISSIONERS

If well telescopes please sketch and show depths.

GROUND LEVEL

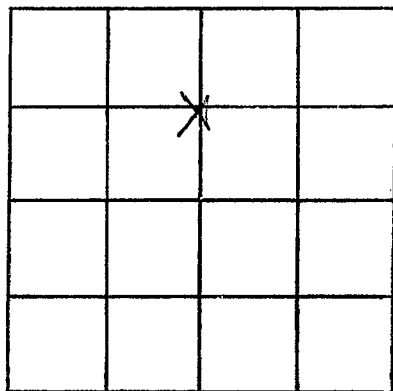

SECTION 8

Please indicate well location X.

ADDITIONAL INFORMATION

If more than one screen, show locations of each on sketch.