

MISSISSIPPI DEPARTMENT OF NATURAL RESOURCES

Bureau of Land and Water Resources

Southport Mall

P.O. Box 10631

Jackson, Mississippi 39209

WATER WELL DRILLERS LOG

TOM GRIFFITH

CODED

Sunflower
P 102
7/29/84

2-29 19 84 PLUMBING & WELL SERVICE, INC. Sunflower Co. MS.
date well completed 320 MATSON AVE. county well located

LANDOWNER: David New Drilling Co.

description of formations encountered

from to

P.O. Box 1487

Natchez, MS. 39120
(mailing address)

Chalk	0'	6'
Sand	6'	60'
P. Gravel	60'	130'

WELL LOCATION:

sec. 16 T. 18 (N) S R. 5 E (W)
10 miles E of Ospreyville
(distance) (direction) (nearest town)

WELL PURPOSE: oil field location
(home, irrigation, municipal, industrial)

WELL COMPLETION DATA:

- (1) diameter (inches) 3"
- (2) total depth (feet) 130'
- (3) static water level (feet) 8' below top of ground.
- (4) casing PVC, 90' (material), (depth)
3" (size) if telescope see back.
- (5) screen 40' (length), 90' (depth to top)
3" (size), slotted PVC (material)
- (6) pump air lift (HP) (yield gpm)
diesel (type power)
- (7) electric log NO (yes or no)
N/A (organization running log)
- (8) how well bottom plugged BWV

CODED

DEPT. OF NATURAL RESOURCES
BUREAU OF LAND & WATER RESOURCES


AUG 7 1984

RECEIVED

DRILLERS REMARKS:

If well telescopes please sketch and show depths.

GROUND LEVEL

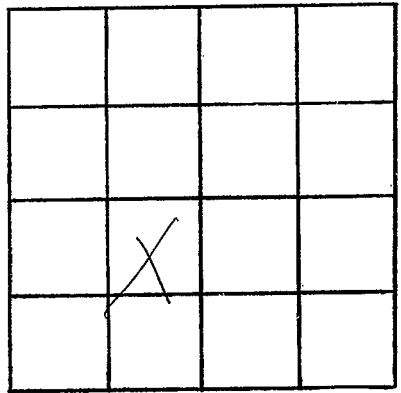

SECTION 116

Please indicate well location X.

ADDITIONAL INFORMATION

If more than one screen,
show locations of each on sketch.