

MISSISSIPPI DEPARTMENT OF NATURAL RESOURCES

Bureau of Land and Water Resources

Southport Mall

P.O. Box 10631

Jackson, Mississippi 39209

WATER WELL DRILLERS LOG

CODED

Sunflower
P 106

June 07 1985 Randy's well's pump Sunflower
date well completed firm name county well located

LANDOWNER: Gordon Deppert

description of formations encountered

from

to

Indianola, ms
(mailing address)

<u>Clay</u>	<u>0</u>	<u>20</u>
<u>FINE SAND</u>	<u>20</u>	<u>40</u>
<u>COARSE SAND & GRAVEL</u>	<u>40</u>	<u>116</u>

WELL LOCATION:

sec. 23 T. 18 N R. 5 E
S S W
5 W miles 2 N of Townsend
(distance) (direction) (nearest town)

CODED

WELL PURPOSE:

(home, irrigation, municipal, industrial)

WELL COMPLETION DATA:

- (1) diameter (inches) 16"
- (2) total depth (feet) 116'
- (3) static water level (feet) 26' below top of ground.
- (4) casing Steel, 76',
(material) (depth)
____ if telescope see back.
(size)
- (5) screen 40', 76'
(length) (depth to top)
16", Steel
(size) (material)
- (6) pump 125, 1800
(HP) (yield gpm)
0
(type power)
- (7) electric log No
(yes or no)

(organization running log)

- (8) how well bottom plugged Steel Plate


DRILLERS REMARKS:

RECEIVED
FEB 18 1986

Department of Natural Resources
Bureau of Land & Water Resources

If well telescopes please sketch and show depths.

GROUND LEVEL

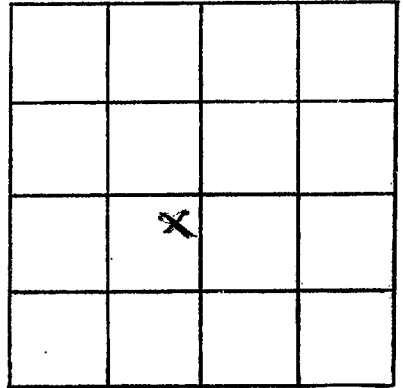

SECTION 28

Please indicate well location X.

ADDITIONAL INFORMATION

If more than one screen,
show locations of each on sketch.