

MISSISSIPPI DEPARTMENT OF NATURAL RESOURCES

Bureau of Land and Water Resources

Southport Mall

P.O. Box 10631

Jackson, Mississippi 39209

WATER WELL DRILLERS LOG

CODED

Sunflower
P. 107

date well completed June 08 19 85 firm name Lewis well pump county well located Sunflower

LANDOWNER: Boston Bennett

description of formations encountered from to

Indiana, Mo.
(mailing address)

CLAY	0	30
FINE SAND	30	55
COARSE SAND & GRAVEL	55	116

WELL LOCATION:

sec. 24 T. 18 N R. 5 E
S 5 W
4 1/2 miles 2 N of Emmerson
(distance) (direction) (nearest town)

CODED

WELL PURPOSE:

(home, irrigation, municipal, industrial)

WELL COMPLETION DATA:

- (1) diameter (inches) 1 1/2"
- (2) total depth (feet) 116'
- (3) static water level (feet) 26' below above
top of ground.
- (4) casing Steel, 7 1/2'
(material) (depth)

(size) If telescope see back.
- (5) screen 40', 7 1/2'
(length) (depth to top)
1 1/2", Steel
(size) (material)
- (6) pump 100, 1400
(HP) (yield gpm)
0
(type power)
- (7) electric log no
(yes or no)

(organization running log)

(8) how well bottom plugged Steel Plate


RECEIVED
FEB 16 1986

DRILLERS REMARKS:

Department of Natural Resources
Bureau of Land & Water Resources

If well telescopes please sketch and show depths.

GROUND LEVEL

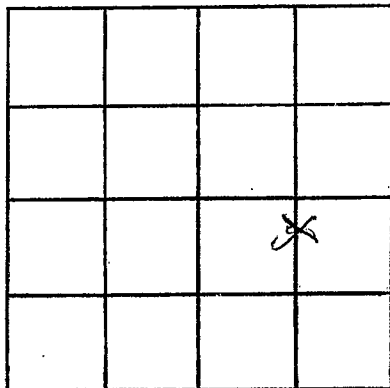

SECTION 24

Please indicate well location X.

ADDITIONAL INFORMATION

Lined area for additional information.

If more than one screen, show locations of each on sketch.