

MISSISSIPPI DEPARTMENT OF NATURAL RESOURCES

Bureau of Land and Water Resources

Southport Mall

P.O. Box 10631

Jackson, Mississippi 39209

WATER WELL DRILLERS LOG

CODED

Sunflower  
P 108

Oct. 8

19 85

Bruce Berryman

Sunflower

date well completed

firm name

Greenwood, MS

county well located

LANDOWNER: Tri-State Leasing

description of formations encountered

from to

Hwy 82W.

Clay

0 40

Indianola, MS 38751

Sand & gravel

40 180

(mailing address)

Clay

180 320

WELL LOCATION:

Sand

320 360

sec. 5 T. 18 N. R. 5 E S 5 W  
2 miles east of Holly  
(distance) (direction) (nearest town)

Shale & hard rock

360 380

Sand

380 400

Shale

400 420

Shale & str. sand

420 520

Sand & str. shale

520 580

Sand

580 640

WELL PURPOSE: H.O.  
(home, irrigation, municipal, industrial)

WELL COMPLETION DATA:

CODED

(1) diameter (inches) 4" x 2"

(2) total depth (feet) 639'

(3) static water level (feet) 18' below top of ground.

(4) casing 4" blk - 168'  
2" gal (material) (depth) 451'

(size) if telescope see back.

(5) screen 20' (length) 619' (depth to top)

2" .010 ga. Stainless steel (size) (material)

(6) pump 3 h.p. 45 (HP) (yield gpm)

Electric (type power)

(7) electric log NO (yes or no)

(organization running log)

(8) how well bottom plugged B.P.V.


DRILLERS REMARKS:

RECEIVED  
FEB 18 1986

Department of Natural Resources  
Bureau of Land & Water Resources

If well telescopes please sketch and show depths.

GROUND LEVEL

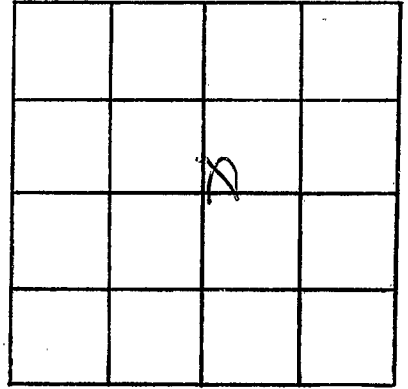

SECTION 5

Please indicate well location X.

ADDITIONAL INFORMATION

If more than one screen,  
show locations of each on sketch.