

MISSISSIPPI DEPARTMENT OF NATURAL RESOURCES

Bureau of Land and Water Resources

Southport Mall

P.O. Box 10631

Jackson, Mississippi 39209

WATER WELL DRILLERS LOG


CODED

SUNFLOWER
P 109

6-23-86 19 IRRIGATION EQUIPMENT SUNFLOWER
 date well completed firm name county well located

LANDOWNER: <u>INDIANOLA</u>	description of formations encountered	from	to
<u>Public schools Hwy. 82 E</u>			
<u>INDIANOLA, MS 38751</u> (mailing address)	<u>clay</u>	<u>0</u>	<u>50</u>
	<u>FINE SAND</u>	<u>50</u>	<u>60</u>
	<u>COARSE SAND / pebbles</u>	<u>60</u>	<u>105</u>
WELL LOCATION: sec. <u>16</u> T <u>18</u> <u>N</u> R. <u>5</u> <u>E</u> S W <u>7</u> miles <u>SW</u> of <u>INDIANOLA</u> (distance) (direction) (nearest town)			
WELL PURPOSE: <u>SOY BEANS</u> (home, irrigation, municipal, industrial)			
WELL COMPLETION DATA: (1) diameter (inches) <u>10"</u> (2) total depth (feet) <u>105</u> (3) static water level (feet) <u>28</u> <u>below</u> above top of ground. (4) casing <u>PVC</u> <u>65'</u> (material) (depth) <u>10"</u> if telescope see back. (size) (5) screen <u>40'</u> <u>65'</u> (length) (depth to top) <u>10"</u> <u>PVC</u> (size) (material) (6) pump <u>15</u> <u>900</u> (HP) (yield gpm) <u>Electric</u> (type power) (7) electric log <u>NO</u> (yes or no) (organization running log) <u>PVC</u> <u>CAP</u> (8) how well bottom plugged			

CODED

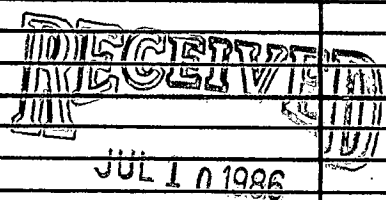

Department of Natural Resources
 Bureau of Land and Water Resources

DRILLERS REMARKS:
#MS-GW-02740
Rebel FARMS

If well telescopes please sketch and show depths.

IRRIGATION EQUIPMENT
601/887-2555
INDIANOLA, MS

GROUND LEVEL

	X		

SECTION 16

Please indicate well location X.

ADDITIONAL INFORMATION

If more than one screen,
show locations of each on sketch.