		ell Report	For Office Use Only:
Sunflower County:		art 1	For Onice Use Only.
Permit #: 60041518		t of Environmental Quality	Aquifer:
Irrigation Equipment		nd Water Resources	Well #: P- 142
Driller		30x 10631 18 39289-0631	L. S. Elevation:
Date drilling completed: $2-12-07$		961-5210	L. S. Elevation:
		4-6938 (fax)	E-log #:
State Law requires that this repo		driller in detail and filed w	ith the Department within
30 days of completion of drilling Well Owner Informat		Well	Location
		33 25 40.5	90 40 19.1
Owner Name H.E. & Z.F. Cu	urtis, LP	Latitude:'	" Longitude:'
Mailing Address: 7718 Valer	<u>ntine Road</u>		90 40 19.1 "Longitude: (19) be): Conventional Survey,
		USGS quad, Hand-held	GPS, Survey-grade GPS
North Little	Rock AR	1 + <sup>74</sup> - <sup>74</sup> Dec	1 wilKig
City State		Distance Direction	
501 - 945 - 2426 Telephone No. ( )	72117	-1 Miles SW	of
	Well	Data	
Purpose of Well (circle one) Home Indu	ustrial Public Supply	Irrigation Fish Culture	Other:
Date well drilling started: $2-12-$	-07 Date	well drilling completed: 2	-12-07
If flowing, method of flow regulation: Value		lescribe)	
			0 4 6 0 5
Static Water Level: <u>33'</u> feet abo	ove of below) (circle one)	and surface Date measured:	2-16-07
· · · · · · · · · · · · · · · · · · ·		and surface Date measured:air line other:	
Method of Measurement (circle one) (ste	eel tape electric tape	air line other:	
· · · · · · · · · · · · · · · · · · ·	eel tape electric tape	air line other:	
Method of Measurement (circle one) (ste Hole depth: <u>126</u> Well dept	eel tape electric tape	air line other:	
Method of Measurement (circle one) (ste Hole depth: <u>126</u> Well dept Type of grout (circle one): Cement	eel tape electric tape th: <u>126</u> Bentonite Mix	air line other: Well grouted to a depth of	10 feet
Method of Measurement (circle one) (ste Hole depth: <u>126</u> Well dept Type of grout (circle one): Cement Casing length: <u>86</u> feet Casing	eel tape electric tape th: 126 Kentonite Mix ng diameter: 16	air line other: Well grouted to a depth of	10 feet PVC Sch.40
Method of Measurement (circle one) (ste Hole depth: <u>126</u> Well dept Type of grout (circle one): Cement	eel tape electric tape th: 126 Kentonite Mix ng diameter: 16	air line other: Well grouted to a depth of	10 feet PVC Sch.40
Method of Measurement (circle one) (ste Hole depth: <u>126</u> Well dept Type of grout (circle one): Cement Casing length: <u>86</u> feet Casing	eel tape electric tape th: 126 Kentonite Mix ng diameter: 16	air line other: Well grouted to a depth of inches Type of casing: inches Type of screen:	10 feet PVC Sch.40 PVC Sch.40
Method of Measurement (circle one)  ste    Hole depth:  126  Well dept    Type of grout (circle one):  Cement    Casing length:  86  feet  Casing    Screen length:  40  feet  Screen	eel tape electric tape th: 126 Bentonite Mix ag diameter: 16 setting depth: From _	air line other: Well grouted to a depth of inches Type of casing: inches Type of screen:	10    feet      PVC Sch.40      PVC Sch.40      126
Method of Measurement (circle one) (ste Hole depth: <u>126</u> Well dept Type of grout (circle one): Cement Casing length: <u>86</u> feet Casing Screen length: <u>40</u> feet Screet Screen slot size: <u>050</u> inches	eel tape electric tape th: 126 Bentonite Mix ag diameter: 16 en diameter: 16 Setting depth: From _ Gravel packed Under	air line other: Well grouted to a depth of inches Type of casing: inches Type of screen: 	10  feet    PVC Sch.40    PVC Sch.40    126  feet    hole  Natural Development
Method of Measurement (circle one) (ste Hole depth: <u>126</u> Well dept Type of grout (circle one): Cement Casing length: <u>86</u> feet Casing Screen length: <u>40</u> feet Screet Screen slot size: <u>050</u> inches	eel tape electric tape th: 126 Bentonite Mix ag diameter: 16 en diameter: 16 Setting depth: From _ Gravel packed Under	air line other: Well grouted to a depth of inches Type of casing: inches Type of screen: 87feet to	10  feet    PVC Sch.40    PVC Sch.40    126  feet    hole  Natural Development
Method of Measurement (circle one) (ste Hole depth: <u>126</u> Well dept Type of grout (circle one): Cement Casing length: <u>86</u> feet Casing Screen length: <u>40</u> feet Screet Screen slot size: <u>050</u> inches	eel tape electric tape th: 126 Rentonite Mix ag diameter: 16 en diameter: 16 Setting depth: From _ Gravel packed Under Other (describe):	air line other: Well grouted to a depth of inches Type of casing: inches Type of screen: 	10  feet    PVC Sch.40    PVC Sch.40    126  feet    hole  Natural Development
Method of Measurement (circle one) (ste Hole depth: <u>126</u> Well dept Type of grout (circle one): Cement Casing length: <u>86</u> feet Casing Screen length: <u>40</u> feet Screet Screen slot size: <u>050</u> inches Type of completion (circle all applicable):	eel tape electric tape th: 126 Bentonite Mix ag diameter: 16 en diameter: 16 Setting depth: From _ Gravel packed Under Other (describe): feet. If te	air line other: Well grouted to a depth of inches Type of casing: inches Type of screen: 87feet to reamed Telescoped Open	10  feet    PVC Sch.40    PVC Sch.40    126  feet    hole  Natural Development    een, describe on back of page
Method of Measurement (circle one) (ste Hole depth: <u>126</u> Well dept Type of grout (circle one): Cement Casing length: <u>86</u> feet Casing Screen length: <u>40</u> feet Screet Screen slot size: <u>050</u> inches Type of completion (circle all applicable): Top of lap pipe or reduction in casing: Logs run (circle all applicable): No log run	eel tape electric tape th: 126 Bentonite Mix ag diameter: 16 en diameter: 16 Setting depth: From _ Gravel packed Under Other (describe): feet. If te	air line other: Well grouted to a depth of inches Type of casing: inches Type of screen: 87feet to reamed Telescoped Open	10  feet    PVC Sch.40    PVC Sch.40    126  feet    hole  Natural Development    een, describe on back of page
Method of Measurement (circle one) (ste Hole depth: <u>126</u> Well dept Type of grout (circle one): Cement Casing length: <u>86</u> feet Casing Screen length: <u>40</u> feet Screet Screen slot size: <u>050</u> inches Type of completion (circle all applicable): Top of lap pipe or reduction in casing:	eel tape electric tape th: 126 Rentonite Mix ag diameter: 16 en diameter: 16 Setting depth: From Gravel packed Under Other (describe): feet. If te	air line other: Well grouted to a depth of inches Type of casing: inches Type of screen: feet to reamed Telescoped Open descoped or more than one scr Density Sonic Neutron	10  feet    PVC Sch.40    PVC Sch.40    126  feet    hole  Natural Development    een, describe on back of page    Other:
Method of Measurement (circle one) (ste Hole depth: <u>126</u> Well dept Type of grout (circle one): Cement Casing length: <u>86</u> feet Casing Screen length: <u>40</u> feet Scree Screen slot size: <u>050</u> inches Type of completion (circle all applicable): Top of lap pipe or reduction in casing: Logs run (circle all applicable): No log run Name of organization running log(s): I certify that the well was drilled, constru	eel tape electric tape th: 126 Bentonite Mix ag diameter: 16 en diameter: 16 Setting depth: From Grivel packed Under Other (describe): feet. If te Electric Gamma Ray	air line other: Well grouted to a depth of inches Type of casing: inches Type of screen: inches Type of screen: feet to reamed Telescoped Open Hescoped or more than one scr Density Sonic Neutron	10  feet    PVC Sch.40    PVC Sch.40    126  feet    hole  Natural Development    een, describe on back of page    Other:    requirements of the Mississipper
Method of Measurement (circle one) (ster Hole depth: <u>126</u> Well dept Type of grout (circle one): Cement Casing length: <u>86</u> feet Casing Screen length: <u>40</u> feet Screet Screen slot size: <u>050</u> inches Type of completion (circle all applicable): Top of lap pipe or reduction in casing: Logs run (circle all applicable): No log run Name of organization running log(s): I certify that the well was drilled, constru Department of Environmental Quality and	eel tape electric tape th: 126 Rentonite Mix ag diameter: 16 setting depth: From Gravel packed Under Other (describe): feet. If te Electric Gamma Ray ucted, and completed in nd/or the Mississippi De	air line other: Well grouted to a depth of inches Type of casing: inches Type of screen: inches Type of screen: feet to reamed Telescoped Open Hescoped or more than one scr Density Sonic Neutron	10  feet    PVC Sch.40    PVC Sch.40    126  feet    hole  Natural Development    een, describe on back of page    Other:    requirements of the Mississipper
Method of Measurement (circle one) (ste Hole depth: <u>126</u> Well dept Type of grout (circle one): Cement Casing length: <u>86</u> feet Casing Screen length: <u>40</u> feet Scree Screen slot size: <u>050</u> inches Type of completion (circle all applicable): Top of lap pipe or reduction in casing: Logs run (circle all applicable): No log run Name of organization running log(s): I certify that the well was drilled, constru	eel tape electric tape th: 126 Rentonite Mix ag diameter: 16 setting depth: From Gravel packed Under Other (describe): feet. If te Electric Gamma Ray ucted, and completed in nd/or the Mississippi De	air line other: Well grouted to a depth of inches Type of casing: inches Type of screen: inches Type of screen: feet to reamed Telescoped Open Hescoped or more than one scr Density Sonic Neutron	10  feet    PVC Sch.40    PVC Sch.40    126  feet    hole  Natural Development    een, describe on back of page    Other:    requirements of the Mississipper

•

FEB 27 2007 BY: OLWR If well telescopes please sketch below and show depths.


Ground Level

Description of Formations Encountered	From	То
Clay		22
Fine Sand	23	<u>35</u> 51
Fine Sand/gravel	36	51
Fine Sand/gravel Med. Sand/gravel	52	126
lieu. Build/gluvel		
		<b>↓</b>
	_	
	1	
	+	11
		+{
		<u>├</u> ──┤
· · · · · · · · · · · · · · · · · · ·		
·	_	$\vdash$
	1	1 1

,

If more than one screen, show location of each on sketch

Sketch the property layout and include the following: 1) the well location; 2) any permanent structures on the property that may aid in locating the well; 3) any roads, power lines, or other items that may aid in locating the property and the well; 4) indicate direction.

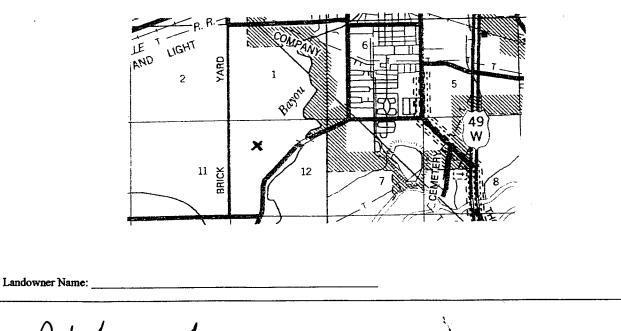

Signature of Water Well Contractor

County: Sunflower Permit #: $\omega 41518$ Irrigation Equipm Drille: 2-12-07 Date completed: 2-12-07	Pump Installe Mississippi Departm Office of Lan Dent P.C Jackson (60	Part 2 er's Completion Report ment of Environmental Quality ad and Water Resources D. Box 10631 a, MS 39289-0631 01)961-5210 1354-6938 (fax)	For Office Use Only:      Aquifer:      Well #:	
This report should be prepar installation of pump.	ed by the pump installer in d	ctail and filed with the Departm	ent within 30 days of the	
Well Owner Is		We	Well Location	
Dwner Name:	. Curtis, LP	Latitude:	_Longitude:	
Mailing Address: 7718 Va.	lentine Road	Method of Lat/Long (circle of	ne): Conventional Survey,	
		USGS quad, Han	d-held GPS, Survey-grade GPS	
	ttle Rock AR	<u>SE ¼ NW ¼ Sec</u>	<u>12</u> <b>Twn</b> <u>18N</u> <b>Rng</b> <u>5</u> W	
<b>City</b> 501-94	72117	Distance Direction	Nearest Town	
501 - 94      Felephone No. ()		Miks	fIndianola	
Pump 1	VDC		wer Type	
Circle			ircle one	
Air Lift Jet	Submersible	Diesel Engine Gasoli	ne Engine Natural Gas	
Bucket Piston	Turbine	Electric Motor Hand	Tractor PTO	
Centrifugal Rotary	Flowing Well	Windmill Other	(specify):	
Other (specify):		Horse Power Rating of Motor	<u>    60                                </u>	
Date Pump Installed: 2-1	6-07	Setting Depth: 70	fcct	
Rated Pump Capacity: 2800	)Gallons Per Minute	Number of Stages:1		
Pump Tes	t Data		easuring Water Level	
Date Well Tested:			suring Line Steel Tape	
Static Water Level (A):	Feet Below Land Surface			
Pumping Water Level (B):	Feet Below Land Surface	Other (specify):		
Drawdown [(B) – (A)]:Feet Below Land Surface		For flowing well, measured shut in head:feet		
Test Pumping Rate:	Gallons Per Minute	Well yielded	_GPM with a drawdown of	
Duration of Pump Test (minimum 4	hours):hours	feet after _	hours of pumping	
HEREBY CERTIFY that the above	e statements are true to the bes	t of my knowledge.		
		11 + 1 h	/ 1	

<u>Gregeve</u>