

State Well Report

Part 1

Mississippi Department of Environmental Quality
Office of Land and Water Resources
P.O. Box 10631
Jackson, MS 39289-0631
(601)961-5210
(601)354-6938 (fax)

For Office Use Only:

Aquifer: _____
Well #: P-156
L. S. Elevation: _____
E-log #: _____

County: Sanflower
Permit #: 444725
Irrigation Equipment
Driller: _____
Date drilling completed: 11-24-08

State Law requires that this report be prepared by the driller in detail and filed with the Department within 30 days of completion of drilling of the well.

Well Owner Information	Well Location
Owner Name: <u>Rebel Farms</u>	Latitude: <u>33° 23' 07"</u> Longitude: <u>90° 45' 05"</u>
Mailing Address: <u>273 Sykes Rd.</u>	Method of Lat/Long (circle one): <u>Conventional Survey</u>
<u>Indianola Ms. 38751</u>	USGS quad, Hand-held GPS, Survey-grade GPS
City State Zip Code	<u>NE 1/4 NE 1/4 Sec 30 Twn 18N Rng 5W</u>
Telephone No. <u>(662) 887-2826</u>	Distance Direction Nearest Town
<u>(662) 887-3267</u>	<u>3</u> Miles <u>NW</u> of <u>Woodburn</u>

Well Data	
Purpose of Well (circle one) Home Industrial Public Supply <u>Irrigation</u> Fish Culture Other: _____	Well Data <u>Pivot</u>
Date well drilling started: <u>11-24-08</u>	Date well drilling completed: <u>11-24-08</u>
If flowing, method of flow regulation: Valve _____ Other (describe) _____	
Static Water Level: <u>22</u> feet above of <u>below</u> (circle one) land surface	Date measured: <u>11-24-08</u>
Method of Measurement (circle one) <u>steel tape</u> electric tape air line other: _____	
Hole depth: <u>120</u> Well depth: <u>120</u> Well grouted to a depth of <u>10</u> feet	
Type of grout (circle one): Cement <u>Bentonite</u> Mix	
Casing length: <u>80</u> feet Casing diameter: <u>16</u> inches Type of casing: <u>PVC</u>	
Screen length: <u>40</u> feet Screen diameter: <u>16</u> inches Type of screen: <u>PVC</u>	
Screen slot size: <u>.050</u> inches Setting depth: From <u>81</u> feet to <u>120</u> feet	
Type of completion (circle all applicable): <u>Gravel packed</u> Underreamed Telescoped Open hole Natural Development	
Other (describe): _____	
Top of lap pipe or reduction in casing: _____ feet. If telescoped or more than one screen, describe on back of page	
Logs run (circle all applicable): <u>No log run</u> Electric Gamma Ray Density Sonic Neutron Other: _____	
Name of organization running log(s): _____	

I certify that the well was drilled, constructed, and completed in accordance with all applicable requirements of the Mississippi Department of Environmental Quality and/or the Mississippi Department of Health regulations and state laws.

Irrigation Equipment Inc.
John P. Chism 0439

Print Name of Water Well Contractor and License No. _____ Signature of Water Well Contractor

RECEIVED
DEC 01 2008
BY: OLWR

P-156

If well telescopes please sketch below and show depths.

Ground Level

GW44425


Description of Formations Encountered	From	To
Clay	0	19
Fine Sand +	20	38
Fine Sand + Gravel	39	60
Medium Sand + Gravel	61	120

If more than one screen, show location of each on sketch

Sketch the property layout and include the following: 1) the well location; 2) any permanent structures on the property that may aid in locating the well; 3) any roads, power lines, or other items that may aid in locating the property and the well; 4) indicate direction.

Rebel Farms

Landowner Name: Bobby Maxey

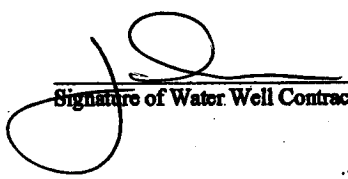

 Signature of Water Well Contractor

RECEIVED
 DEC 01 2008
 BY: OLWR

STATE WELL REPORT

Part 2

Pump Installer's Completion Report
 Mississippi Department of Environmental Quality
 Office of Land and Water Resources
 P.O. Box 10631
 Jackson, MS 39289-0631
 (601)961-5210
 (601)354-6938 (fax)

County: Sunflower
 Permit #: 66044425
 Irrigation Equipment
 Driller: _____
 Date completed: 11-24-08

For Office Use Only:

Aquifer: _____
 Well #: P-156
 Elevation: _____

This report should be prepared by the pump installer in detail and filed with the Department within 30 days of the installation of pump.

Well Owner Information	Well Location
Owner Name: <u>Rebel Farms</u> Mailing Address: <u>273 Sykes Road</u> <u>Indianola Ms. 38751</u> <small>City State Zip Code</small> Telephone No. <u>662 887-2826</u> <u>887-3267</u>	Latitude: _____ Longitude: _____ Method of Lat/Long (circle one): Conventional Survey, USGS quad, Hand-held GPS, Survey-grade GPS <u>NE 1/4 NE 1/4 Sec 30 Twn 18N Rng 5W</u> Distance Direction Nearest Town <u>3 Miles NW of Woodburn</u>

Pump Type Circle one	Power Type Circle one
Air Lift Jet Submersible Bucket Piston <u>Turbine</u> Centrifugal Rotary Flowing Well Other (specify): _____ Date Pump Installed: <u>11-24-08</u> Rated Pump Capacity: _____ Gallons Per Minute	<u>Diesel Engine</u> Gasoline Engine Natural Gas Electric Motor Hand Tractor PTO Windmill Other (specify): _____ Horse Power Rating of Motor: <u>80</u> Setting Depth: <u>60</u> feet Number of Stages: <u>4</u>

Pump Test Data	Method of Measuring Water Level Circle one
Date Well Tested: _____ Static Water Level (A): _____ Feet Below Land Surface Pumping Water Level (B): _____ Feet Below Land Surface Drawdown [(B) - (A)]: _____ Feet Below Land Surface Test Pumping Rate: _____ Gallons Per Minute Duration of Pump Test (minimum 4 hours): _____ hours	Air Line Electric Measuring Line Steel Tape Other (specify): _____ For flowing well, measured shut in head: _____ feet Well yielded _____ GPM with a drawdown of _____ feet after _____ hours of pumping

I HEREBY CERTIFY that the above statements are true to the best of my knowledge.

John P. Chism 0439
 Print Name of Pump Installer and License No. (if applicable) Signature of Pump Installer

RECEIVED
 DEC 01 2008
 BY: OLWR