

County: Sunflower
 Permit #: GW-44105
 Driller: Irrigation Equipment
 Date drilling completed: 5-8-10

State Well Report
Part 1 - Driller's Log
 Mississippi Department of Environmental Quality
 Office of Land and Water Resources
 P.O. Box 2309
 Jackson, MS 39225
 (601)961-5210
 (601)961-5228 (fax)

For Office Use Only:
 Aquifer: P158
 Well #: _____
 L. S. Elevation: _____
 E-log #: _____

State Law requires that this report be prepared by the license holder responsible for the work and filed with the Department at the above address within 30 days of completion of drilling of the well or borehole.

<p>Information on Well Owner (Landowner if borehole is not for a water well)</p> <p>Owner Name <u>Lakewood</u> Mailing Address: <u>Matt D. McGregor</u> <u>1303 Bayou Dr.</u> <u>Indianola Ms. 38751</u> City State Zip Code Telephone No. () _____</p>	<p>Well or Borehole Location</p> <p>Latitude: <u>33° 24' 14.4"</u> Longitude: <u>90° 41' 53.5"</u> Method of Lat/Long (circle one): Conventional Survey, USGS quad <u>(Hand-held GPS)</u> Survey-grade GPS <u>SE 1/4 SE 1/4 Sec 15</u> Twn <u>18N</u> Rng <u>5W</u> Distance Direction Nearest Town <u>3</u> Miles <u>SW</u> of <u>Indianola</u></p>
---	--

Well / Borehole Data

Date drilling started: 5-8-10 Date drilling completed: 5-8-10 Hole depth: 117 Hole diameter: 18"

Location of the source of any surface water used for drilling: Surface Water
 Method of dosing and volume of Chlorine used in drilling and development: 50 PPM

Logs run (circle all applicable): (No log run) Electric Gamma Ray Density Sonic Neutron Other: _____
 Name of organization running log(s): _____

Purpose of borehole (check one): Water Well Geotechnical/Geological Investigation _____ Ground Source Heat Pump _____
 Seismic Survey _____ Other (describe) _____
If drilling is not related to water well construction, skip the remainder of this block

Purpose of Well (check one): Home _____ Industrial _____ Public Supply _____ Irrigation Fish Culture _____ Other: _____

If a flowing well, method of flow regulation: Valve _____ Other (describe) _____

Static Water Level: 28 feet above or (below) (circle one) land surface Date measured: 5-10-10

Method of Measurement (circle one) (steel tape) electric tape air line other: _____

Well depth: 117 Well grouted to a depth of 10 feet Type of grout (circle one): Neat Cement (Bentonite) Mix

Casing length: 77 feet Casing diameter: 10 inches Type of casing: PVC

Screen length: 40 feet Screen diameter: 10 inches Type of screen: PVC

Screen slot size: .050 inches Setting depth: From 78 feet to 117 feet

Type of completion (circle all applicable): (Gravel packed) Underreamed Telescoped Open hole Natural Development
 Other (describe): _____


Top of lap pipe or reduction in casing: _____ feet. *If telescoped or more than one screen, describe on next page*

Form: OLWR-SWR-1A (04/08)

RECEIVED
 MAY 14 2010
 BY: OLWR

The sketch below only required for water wells.

If well telescopes, show depths on sketch.

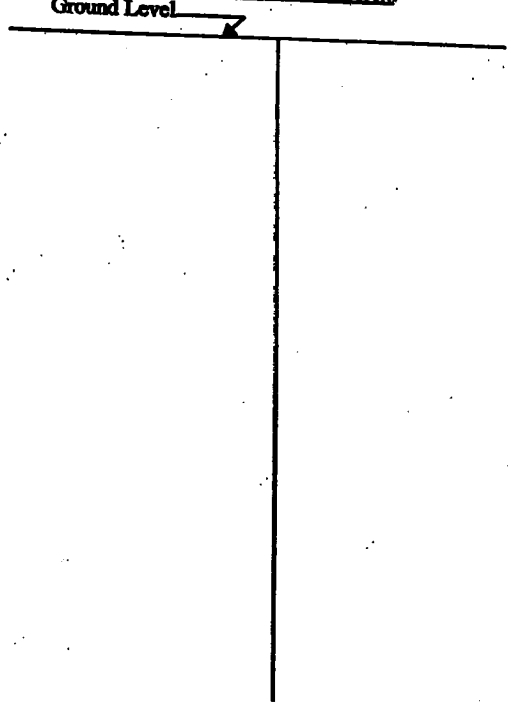

Description of formations encountered must be provided for all wells and boreholes, unless specifically exempted by regulations

Description of Formations Encountered	From (depth)	To (depth)
Clay	Ground Level	17
Fine Sand	18	47
Medium Sand	48	77
Medium Sand + Gravel	78	97
Coarse Sand + Gravel	98	117

If more than one screen, show location of each on sketch

Sketch the property layout and include the following: 1) the well location; 2) any permanent structures on the property that may aid in locating the well; 3) any roads, power lines, or other items that may aid in locating the property and the well; 4) a north arrow.

Landowner Name: Lakewood

Form: OLWR-SWR-1A (04/08)

I certify that the well/borehole was drilled, constructed, and completed in accordance with all applicable requirements of the Mississippi Department of Environmental Quality and the Mississippi Department of Health regulations, if applicable, and state laws.

Patrick M. Chism 0695

Print Name of Responsible Licensee and License No.

Date

Signature of Licensee

RECEIVED
MAY 14 2010
BY: OLWF

P158

County: Sunflower
 Permit #: GW-44105
 Irrigation Equipment
 Driller: _____
 Date completed: 5-8-10
 Copy information from block on Part 1

STATE WELL REPORT

Part 2

Pump Installer's Completion Report
 Mississippi Department of Environmental Quality
 Office of Land and Water Resources
 P.O. Box 2309
 Jackson, MS 39225
 (601)961-5210
 (601)961-5228 (fax)

For Office Use Only:
 Aquifer: _____
 Well #: _____
 Elevation: _____

This part of the report must be completed by a licensed water well contractor or a licensed pump installer. A copy of Part 1 of the report must be attached and both parts filed with the Department at the above address within 30 days of well completion.

Well Owner Information Owner Name: <u>Lakewood</u> Mailing Address: <u>Matt D. McGregor</u> <u>1303 Bayou Dr.</u> <u>Indianola Ms. 38751</u> City State Zip Code Telephone No. () _____		Well Location Latitude: _____ Longitude: _____ Method of Lat/Long (check one): Conventional Survey _____ USGS quad _____, Hand-held GPS <input checked="" type="checkbox"/> , Survey-grade GPS _____ <u>SE 1/4 SE 1/4 Sec 15 T.18N R. 5W</u> Distance Direction Nearest Town <u>3 Miles SW of Indianola</u>
---	--	--

Pump Type Circle one Air Lift Jet <input type="checkbox"/> Submersible <input checked="" type="checkbox"/> Bucket Piston Turbine Centrifugal Rotary Flowing Well Other (specify): _____ Date Pump Installed: <u>5-10-10</u> Rated Pump Capacity: <u>1150 ±</u> Gallons Per Minute	Power Type Circle one Diesel Engine Gasoline Engine Natural Gas Electric Motor <input checked="" type="checkbox"/> Hand Tractor PTO Windmill Other (specify): _____ Horse Power Rating of Motor: <u>30</u> Setting Depth: <u>70</u> feet Number of Stages: <u>1</u>
--	--

Pump Test Data Date Well Tested: _____ Static Water Level (A): _____ Feet Below Land Surface Pumping Water Level (B): _____ Feet Below Land Surface Drawdown [(B) - (A)]: _____ Feet Below Land Surface Test Pumping Rate: _____ Gallons Per Minute Duration of Pump Test (minimum 4 hours): _____ hours	Method of Measuring Water Level Circle one Air Line Electric Measuring Line Steel Tape Other (specify): _____ For flowing well, measured shut in head: _____ feet Well yielded _____ GPM with a drawdown of _____ feet after _____ hours of pumping
---	---

This is for (circle one): New Well Replacement of Existing Pump Repair of Existing Pump

I HEREBY CERTIFY that the above statements are true to the best of my knowledge.
 Patrick M. Chism 0695
 Print Name of Pump Installer and License No. (if applicable) Signature of Pump Installer

Form: OLWR-SWR-1C (01-09)
 RECEIVED
 MAY 14 2010
 BY: DJWF