

SUNFLOWER
 015
 3-25-74

MISSISSIPPI
 BOARD OF WATER COMMISSIONERS
 416 North State Street
 Jackson, Mississippi 39201

WATER WELL DRILLERS LOG

3-25 date well completed 1974 Schultz Drilling firm name Sunflower county well located

LANDOWNER: Sub. Cont
NEW + Aug 1

description of formations encountered	from to	
<u>Top Soil</u>	<u>0</u>	<u>22</u>

(mailing address)

WELL LOCATION:
 sec. 18 T. 18 R. 4
3 miles S of And
 (distance) (direction) (nearest town)

<u>SAND</u>	<u>22</u>	<u>90</u>
-------------	-----------	-----------

WELL PURPOSE: Supply
 (home, irrigation, municipal, industrial)

CODED

WELL COMPLETION DATA:

- diameter (inches) 4"
- total depth (feet) 80
- static water level (feet) 12 below top of ground.
- casing PVC (material), (depth), (size) if telescope see back.
- screen 20 (length), (depth to top) 4" (size), PVC (material)
- pump NONE (HP), (yield gpm) (type power)
- electric log NO (yes or no) (organization running log)
- how well bottom plugged OK


DRILLERS REMARKS:

APR 5 1974

REC'D BY WATER DIVISION

If well telescopes please sketch and show depths.

GROUND LEVEL

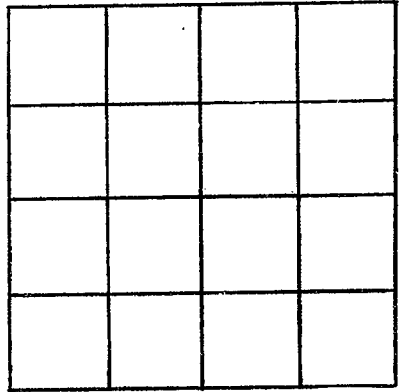

SECTION _____

Please indicate well location X.

ADDITIONAL INFORMATION

If more than one screen, show locations of each on sketch.