

Sunflower

QQZ1
11-29-60

WATER WELL DRILLERS LOG

²
CODED

Date: NOV. 29, 1960, Driller: DELTA DRILLING CO County LEFLORE
(Name)

(1) Owner of Land: J. R. STINSON
(Name)
MOORHEAD, MISS
(Address)

(2) Location: 1/4, 1/4, Sec. 1 T18R4,
_____ miles _____ of _____
(distance) (direction) (Nearest Town)

(3) Topography: _____
(Hilly) (Flat) (Level)

(4) Purpose of Well: _____
(Domestic Irrigation
Municipal, Industrial, Other)

Description & Color of Materials Sand, Clay, Red Clay, Shell, etc.	Thick- ness Feet	Depth Feet
<u>TOP SOIL & GUMBO -</u>	<u>20</u>	<u>20</u>
<u>SAND</u>	<u>42</u>	<u>62</u>
<u>GRAVEL</u>	<u>64</u>	<u>126</u>
<u>GUMBO</u>	<u>85</u>	<u>211</u>
<u>SAND</u>	<u>128</u>	<u>339</u>
<u>GUMBO</u>	<u>63</u>	<u>402</u>
<u>SAND</u>	<u>162</u>	<u>564</u>
<u>GUMBO w/8" ROCK -</u>	<u>66</u>	<u>630</u>
<u>SAND</u>	<u>123</u>	<u>753</u>
<u>GUMB w/7+8" ROCK 18 to</u>		
<u>20' - APART -</u>	<u>84</u>	<u>837</u>
<u>SHELL -</u>	<u>22</u>	<u>859</u>
<u>HARD GUMBO</u>	<u>141</u>	<u>1000</u>
<u>GREEN SAND - COARSE</u>	<u>148</u>	<u>1148</u>
<u>SHELL & ROCK - 8"</u>	<u>64</u>	<u>1212</u>
<u>GUMBO w/12" ROCK -</u>	<u>124</u>	<u>1336</u>
<u>GREY SAND -</u>	<u>83</u>	<u>1419</u>
<u>HARD GUMBO -</u>	<u>93</u>	<u>1512</u>
<u>MED. COARSE SAND -</u>	<u>92</u>	<u>1604</u>
<u>WHITE SAND -</u>	<u>64</u>	<u>1668</u>

Information upon completion of well:

(1) Diameter 3 inches.

(2) Total Depth 1668 feet.

(3) Water Level 55' 7" feet below top of ground.


(4) Cased to 1668', Size 3" 954',
2" 706'

(5) Screen: Size 2", Length 30'
Galv. WIRE WRAPPED ON PIPE.
22' LAP OF 2" IN 3" PIPE.

(6) Were any formations sealed against pollution?
_____ yes, _____ no.

If YES depth of formation _____
Why _____

Drillers Remarks: WELL FLOWED 88 G.P.M.
24# PRESSURE

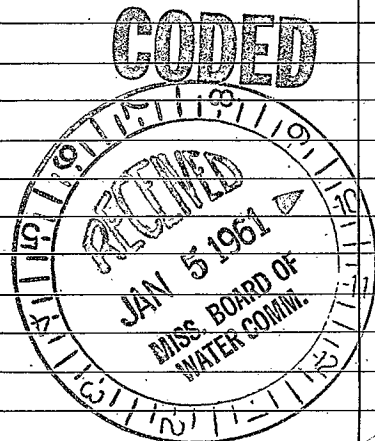

(Use Back

