

WQ22

7-10-62

WATER WELL DRILLERS LOG

CODED

Date: 7/10, 1962, Driller: Bailey Drilling Co. County: Sunflower Washington

(1) Owner of Land: VA Johnson Co Indianola, Miss.

(2) Location: 1/4, 1/4, Sec. 4 T8R4, 6 miles east of Indianola

(3) Topography: Flat


(4) Purpose of Well: Cattle

Table with 3 columns: Description & Color of Materials, Thickness Feet, Depth Feet. Rows include Clay, Sand, and Fine gravel.

Information upon completion of well:

- (1) Diameter 4 inches.
(2) Total Depth 90 feet.
(3) Water Level 23 feet below top of ground.
(4) Cased to all way Size 4.
(5) Screen: Size 4", Length 10ft.
(6) Were any formations sealed against pollution? yes, X no.

CODED

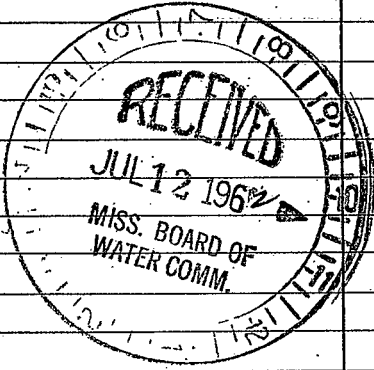

If YES, depth of formation. Why. Drillers Remarks.

(Use Bo...

[The page contains extremely faint and illegible text, likely bleed-through from the reverse side of the document. The text is too light to transcribe accurately.]