

SunFlower
Q-24
8-21-71

MISSISSIPPI
BOARD OF WATER COMMISSIONERS
 416 North State Street
 Jackson, Mississippi 39201

WATER WELL DRILLERS LOG

C14049-3568

CODED
 SunFlower

August 21, 1971 SINGER-Layne Central Division
 date well completed firm name county well located

LANDOWNER:	Description of formations encountered	from	to
Duncan Farms, Inc.	Clay	0	45
Inverness, Mississippi	Fine sand	45	60
(mailing address)	Coarse sand	60	87
	Coarse sand and pea gravel	87	98
WELL LOCATION:	Coarse sand and gravel	98	145
sec. 25 T 18 N R 4 Ex	Coarse sand	145	195
X8 W	Rock	195	197
miles of Inverness	Sand	197	224
(distance) (direction) (nearest town)	Clay	224	255
WELL PURPOSE: domestic	Sand	255	289
(home, irrigation, municipal, industrial)	Sand & clay strks.	289	342
WELL COMPLETION DATA:	Clay	342	555
(1) diameter (inches) 4" x 3"	Sandy clay & sand strks.	555	621
(2) total depth (feet) 740' 2"	Sand	621	635
(3) static water level (feet) 22' below top of ground.	Sandy clay	635	680
(4) casing steel 539' x 3"	Sand & clay strks.	680	687
(material) 148' 3" x 4"	Sand	687	716
4" & 3" If telescope see back.	Clay	715	741
(5) screen 29' 10" 717' 1"			
(length) (depth to top)			
23' 1" of T.P. stainless steel			
(size) (material)			
(6) pump 3 50			
(HP) (yield gpm)			
electric			
(type power)			
(7) electric log no			
(yes or no)			
(organization running log)			
(8) how well bottom plugged 50 shot lbs.			
DRILLERS REMARKS:			


CODED

SEP 13 1971

MISS. Bd. OF
 WATER COMM.

If well telescopes please sketch and show depths.

GROUND LEVEL

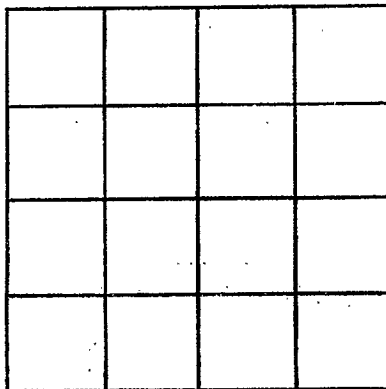

SECTION _____

Please indicate well location X.

ADDITIONAL INFORMATION

If more than one screen,
show locations of each on sketch.