

SUNFLOWER
Q28
2-20-78
E Log #65

MISSISSIPPI
BOARD OF WATER COMMISSIONERS
416 North State Street
Jackson, Mississippi 39201

RECEIVED

1978
CODED

WATER WELL DRILLERS LOG

MISS. BD. OF WATER COMM

2-20-78

date well completed

Layne Central Company

firm name

Sunflower

county well located

LANDOWNER:

City of Indianola

Indianola, MS

(mailing address)

description of formations
encountered

from

to

*

WELL LOCATION:

sec. 6 T 18 N R 4 E
S W

In south part of town
(distance) (direction) (nearest town)

WELL PURPOSE: Municipal
(home, irrigation, municipal, industrial)

WELL COMPLETION DATA:

(1) diameter (inches) 12"
(2) total depth (feet) 1771' 8"
(3) static water level (feet) Flowing below
top of ground.

(4) casing Steel 1704'
(material) (depth)

12"
(size) If telescope see back.

(5) screen 60' 1711' 8"
(length) (depth to top)

8" St. Steel
(size) (material)

(6) pump 50 750
(HP) (yield gpm)

electric
(type power)

(7) electric log Yes
(yes or no)

U.S.G.S.

(organization running log)

Back Pressure


(8) how well bottom plugged Valve

DRILLERS REMARKS:

* See ATTACHED -

If well telescopes please
sketch and show depths.

GROUND LEVEL

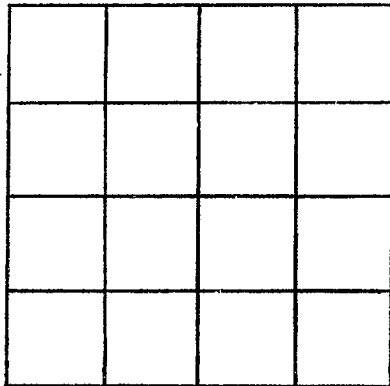

SECTION _____

Please indicate well location X.

ADDITIONAL INFORMATION

If more than one screen,
show locations of each on sketch.