

Sunflower
Q 36
6-25-70

MISSISSIPPI
BOARD OF WATER COMMISSIONERS
416 North State Street
Jackson, Mississippi 39201

CODED

Retn 7/13/70
Rev

WATER WELL DRILLERS LOG

Converted
Sunflower
county well located

June 25 1970 Cleveland Drilling & Pipe Co. firm name
date well completed

LANDOWNER: J. W. James
c/o Phumba Tronson
Inverness Miss
(mailing address)

WELL LOCATION:
sec. 28 T. 18 N. R. 4 E
2 miles N of Inverness
(distance) (direction) (nearest town)

WELL PURPOSE:
(home, irrigation, municipal, industrial)

WELL COMPLETION DATA:
(1) diameter (inches) 4" x 2"
(2) total depth (feet) 860'
(3) static water level (feet) 14' below top of ground.
(4) casing 4" x 56' (material) 719' (depth)
(5) screen 20' (length) 719' (depth to top)
2" (size) S.S. (material)
(6) pump 1 (HP) 30 (yield gpm)
2100 (type power)
(7) electric log No (yes or no)
(organization running log)
(8) how well bottom plugged Back wash valve

description of formations encountered	from	to
Clay	TOP	16'
Sand	16'	90'
Sandy gravel	90'	162'
Clay	162'	186'
Sand	186'	294'
Clay & SHIP	294'	319'
Sand	319'	380'
Clay	380'	401'
Sand	401'	494'
Clay	494'	520'
Clay & Shell	520'	700'
Sand	700'	743'
Clay	743'	786'
Sand	786'	860'

CODED


JUL 13 1970

MISS. Bd. OF WATER COMM.

DRILLERS REMARKS:

If well telescopes please sketch and show depths.

GROUND LEVEL

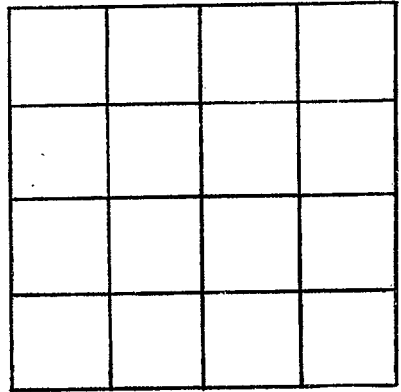

SECTION _____

Please indicate well location X.

ADDITIONAL INFORMATION

If more than one screen, show locations of each on sketch.