

SUNFLOWER
Q37
9-18-70
9-18-70 19

MISSISSIPPI
 BOARD OF WATER COMMISSIONERS
 416 North State Street
 Jackson, Mississippi 39201

CODED

WATER WELL DRILLERS LOG
 DYER WELL & IRRIGATION SERVICE

SUNFLOWER
 county well located

date well completed

firm name

county well located

LANDOWNER:
BAIRD GIN CO
BAIRD, MISS
 (mailing address)

description of formations encountered	from	to
<u>CLAY</u>	<u>0</u>	<u>18</u>
<u>SAND & GRAVEL</u>	<u>18</u>	<u>111</u>

WELL LOCATION:
 sec. 11 T. 18 N R. 4 W
BAIRD
 miles (distance) of (nearest town)

WELL PURPOSE: INDUSTRIAL
 (home, irrigation, municipal, industrial)

WELL COMPLETION DATA:

(1) diameter (inches) 4"

(2) total depth (feet) 111'

(3) static water level (feet) 17' below above top of ground.

(4) casing 4" BUD 81'
 (material) (depth)
4" if telescope see back.
 (size)

(5) screen 20 FT 81'
 (length) (depth to top)
4" PLASTIC
 (size) (material)

(6) pump 3 60
 (HP) (yield gpm)
ELEC
 (type power)

(7) electric log NO
 (yes or no)
 (organization running log)

(8) how well bottom plugged B.P. VALVE

CODED


DRILLERS REMARKS:
WELL IN TOWN OF
BAIRD

NOV 23 1970

MISS. B.D. 158

If well telescopes please sketch and show depths.

GROUND LEVEL

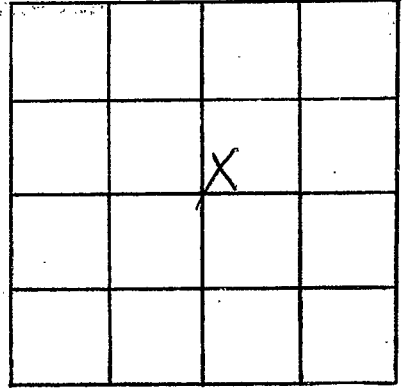

SECTION 11

Please indicate well location X.

ADDITIONAL INFORMATION

If more than one screen, show locations of each on sketch.