

Sunflower  
 Q 40  
 7-67

MISSISSIPPI  
 BOARD OF WATER COMMISSIONERS  
 416 North State Street  
 Jackson, Mississippi 39201

8/3/67 Jm  
 C2463

WATER WELL DRILLERS LOG

July 10, 19 67 Layne-Central Company Sunflower  
 date well completed firm name county well located

LANDOWNER: William Ervin

description of formations encountered

from to

Inverness, Mississippi  
 (mailing address)

WELL LOCATION:


sec. 31 T. 18 N R. 4 W  
 Sx  
 W  
 2 1/2 miles west of Inverness  
 (distance) (direction) (nearest town)

WELL PURPOSE: domestic  
 (home, irrigation, municipal, industrial)

WELL COMPLETION DATA:

- (1) diameter (inches) 4 x 3
- (2) total depth (feet) 813' 4"
- (3) static water level (feet) 20' below top of ground, 669' 7" below galy.
- (4) casing blk. & 105' 10" (material) (depth)  
 4" & 3" if telescope see back.  
 (size)
- (5) screen 29' 11" , 805' 4" (length) (depth to top)  
 8' of 3" galv. pipe  
 3" Stainless steel  
 (size) (material)
- (6) pump 1 1/2 (HP) 30 (yield gpm)  
 electric (type power)
- (7) electric log no (yes or no)  
 (organization running log)
- (8) how well bottom plugged 75 lbs. shot


Clay	0	15
Brown sand	15	21
Fine sand	21	45
Coarse sand	45	71
Coarse sand & pea gravel	71	98
Coarse sand & gravel	98	125
Sand	125	380
Sand, strks. of clay	380	430
Sand, strks. of Brown lignite	430	473
Sand, strks. of sandy clay	473	502
Soft clay	502	553
Sand, strks. of brown clay	553	593
Clay	593	737
Sandy clay, strks. sand	737	750
Sand	750	813

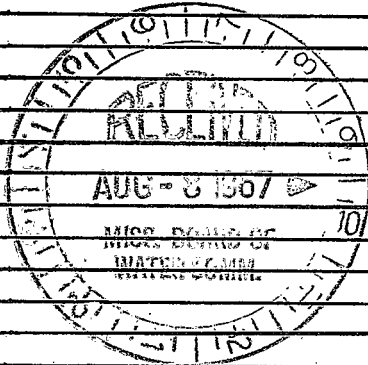

DRILLERS REMARKS:

If well telescopes please sketch and show depths.

GROUND LEVEL

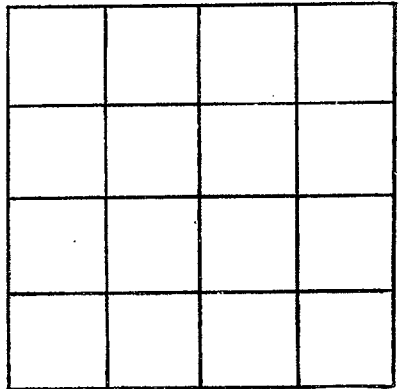

SECTION 18

Please indicate well location X.

ADDITIONAL INFORMATION

If more than one screen,  
show locations of each on sketch.