


SUNF. MISSISSIPPI BOARD OF WATER COMMISSIONERS

Q 41
4-24-63

WATER WELL DRILLERS LOG

Date: APR 24, 1963, Driller: DELTA DRILLING Co. County: SUNFLOWER
(Name)

		Description & Color of Materials Sand, Clay, Red Clay, Shell, etc.	Thick- ness Feet	Depth Feet
(1) Owner of Land: <u>CRAWFORD READ MIX</u> (Name) <u>CONCRETE Co</u>		GUMBO	22	22
<u>INDIANOLA, MISS</u> (Address)		SAND	63	85
		GRAVEL	52	137
(2) Location: <u>NW 1/4, NE 1/4, Sec. 5 T4R14W</u>		GUMBO	63	200
<u>3/4</u> miles <u>SOUTH</u> , of <u>INTERSECT</u> (distance) (direction) (Nearest Town)	<u>HIWAY 498</u>	SHALE	73	273
		SAND	51	324
(3) Topography: _____ (Hilly) (Flat) (Level)		SHALE	54	378
		SAND	134	512
(4) Purpose of Well: <u>INDUSTRIAL</u> (Domestic Irrigation Municipal, Industrial, Other)		SHALE	52	564
		SAND	34	598
		SHALE	130	728
		SAND	123	851
		GUMBO	49	900
		SHALE	68	968
		SAND	75	1043
		GUMBO	77	1120
		GREEN SAND	83	1203
		SHALE	78	1281
		GUMBO	26	1307
		SAND	8.5	1392
		SHALE	41	1433
		SAND	78	1461
		SHALE	34	1495
		SAND	17	1512
		GUMBO	53	1565
		SHALE	25	1600
		SAND	98	1658
		SHALE	70	1668
		SAND	103	1721
Information upon completion of well:				
(1) Diameter <u>3</u> inches. <u>W/4" TOP</u>				
(2) Total Depth <u>1721</u> feet.				
(3) Water Level <u>WELL FLOWS</u> feet below top of ground.				
(4) Cased to <u>1701</u> , Size <u>4" 75'</u> <u>3" 619'</u>				
(5) Screen: Size <u>2"</u> , Length <u>2.5'</u>				
(6) Were any formations sealed against pollution? _____ yes, _____ no.				
If YES depth of formation _____				
Why _____				
Drillers Remarks: <u>WELL FLOWS 80 GPM.</u> <u>20# PRESSURE.</u>				

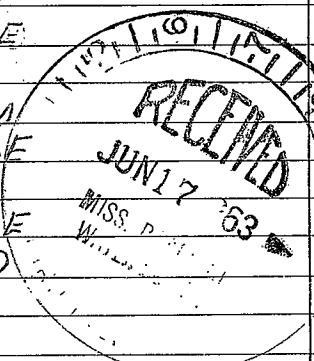

(Use Back Side)

Well No.

Faint, illegible text, possibly bleed-through from the reverse side of the page. The text is scattered across the page and is mostly illegible due to low contrast and blurriness.